

A-27862  
27591

## SUPPLEMENTAL AGREEMENT

Vol. 77 Page 5538

On November 20, 1972, a Lease No. 721, hereinafter designated as the "Original Lease", was entered into between ~~WEYERHAEUSER COMPANY~~ OREGON, CALIFORNIA and EASTERN RAILWAY COMPANY and HARRY R. WAGGONER. Said Lease was supplemented on July 2, 1975.

The parties mutually agree that the Original Lease shall be and is hereby further supplemented as follows:

1. The premises of said Railway Company covered by the Lease are amended as shown in red outline on the print marked "Exhibit A" dated July 19, 1976.
2. The cross-hatched area is leased for ingress and egress, so long as said use does not interfere with normal operation of Railroad.
3. "to construct or permit the construction of additional facilities on said premises" is deleted from Paragraph 12.

Except as herein expressly provided, all of the terms and conditions of the Original Lease, as heretofore supplemented, shall remain unmodified.

IN WITNESS WHEREOF, the parties hereto have executed this Supplemental Agreement in duplicate as of the 16<sup>th</sup> day of February 1978.

~~WEYERHAEUSER COMPANY~~  
OREGON, CALIFORNIA and EASTERN RAILWAY COMPANY

By [Signature]  
Vice President

Harry R. Waggoner

[Signature]


FORM 425 10/62

I, V. E. Ried, Land Records Supervisor for Weyerhaeuser Company, hereby certify that the above is a true copy of a document in our files.

WEYERHAEUSER COMPANY

BY: V.E. Ried  
Land Records Supervisor

5539

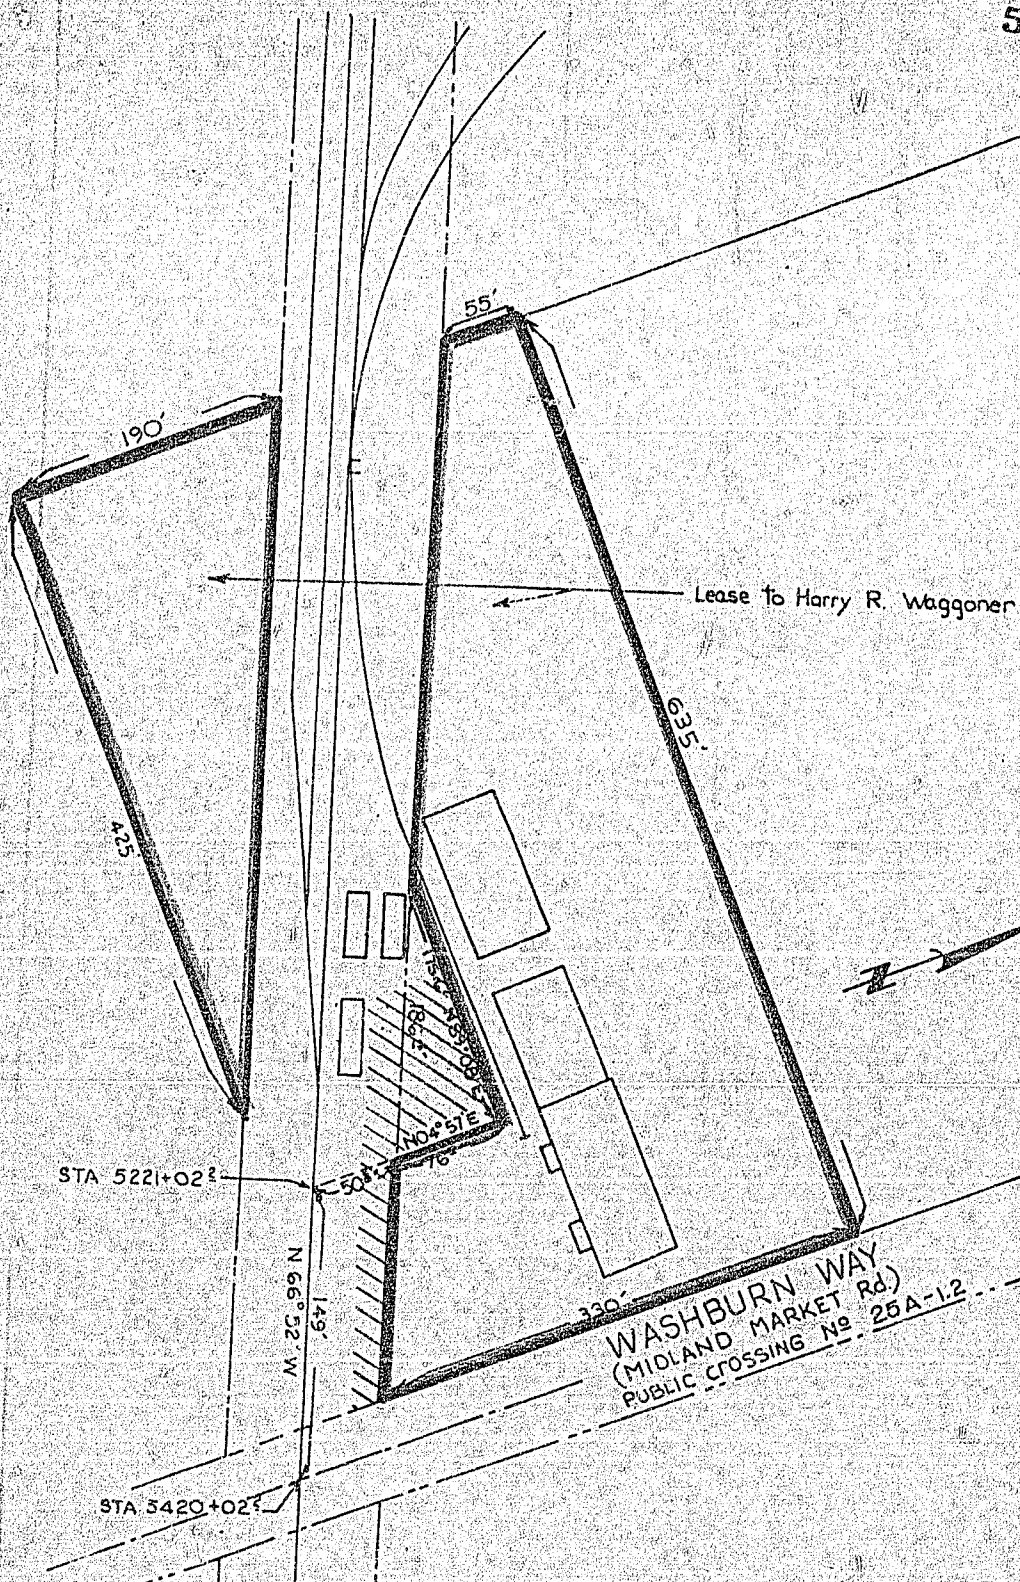

INGRESS & REGRESS AREA  
SHADED AREA = 0.2 acres

Scale: 1"=100' Date: 7-19-76

STATE OF OREGON; COUNTY OF KLAMATH; ss.

I hereby certify that the within instrument was received and filed for record on the 4th day of APRIL A.D., 19 77 at 11:40 o'clock A M., and duly recorded in Vol. N 77 of DEEDS on Page 5538.

FEE \$ 6.00

WM. D. MILNE, County Clerk

By Hazel D. Milne Deputy

EXHIBIT A

26. DECORATION  
NONE  
NATION  
RIFLE  
27. REMARKS  
Good Com  
Completed  
Completed  
NOT A FIN