

24861

Vol M96 Page 28698

When recorded, return to:

Parcel No. OR-KL-2490APN: 390902300-01300

PGT - Land Dept.
 P.O. Box 547
 Redmond, OR 97758-0125

NOTICE OF LOCATION

PACIFIC GAS TRANSMISSION COMPANY, a California corporation, pursuant to the rights conveyed to it by that certain grant of easement dated October 20, 1994 and recorded in Vol M94 of Deeds at Page 32645 in the Official Records of the County of Klamath, State of Oregon, does hereby further define the location of the strip of lands described in said grant as follows on the attached Exhibit A.

Nothing herein contained shall, or shall be construed to, modify in any way to terminate any of the rights and obligations of the parties under and by virtue of the said grant of easements in the lands therein described or the said strip thereof.

IN WITNESS WHEREOF, the undersigned has executed these presents this 20th day of August, 1996.

PACIFIC GAS TRANSMISSION COMPANY

By: W.G. Thomas
 W.G. Thomas, Director Land TR

STATE OF OREGON }
 } ss.
 County of Multnomah }

On this 20th day of August, 1996 before me appeared W. G. Thomas, to me personally known, who being duly sworn, did say that he, the said W. G. Thomas is the Land Director of Pacific Gas Transmission Company, the within named Corporation, and that the said instrument was signed in behalf of said Corporation by authority of its Board of Directors, and W. G. Thomas acknowledges said instrument to be the free act and deed of said Corporation.

IN WITNESS WHEREOF, I have hereunto set my hand and affixed my official seal the day and year in this Certificate first above written.

Dino Angelosante
 DINO ANGELOSANTE
 NOTARY PUBLIC FOR OREGON
 My Commission Expires: August 16, 1998



96 SEP 12 AM 1:38

KLAMATH COUNTY, OREGON
SEC. 23, T-39-S, R-9-E, W.M.

REGISTERED
PROFESSIONAL
LAND SURVEYOR

Joe A. Feyer
OREGON
JANUARY 17, 1985
JOSEPH A. FEYDER
2692

RENEWAL DATE 12-31-97

NARRATIVE

1. THE PURPOSE OF THIS MAP AND NOTATIONS IS TO DEPICT AND DESCRIBE AN EASEMENT, BEING A PORTION OF THE SOUTHEAST QUARTER OF THE NORTHEAST QUARTER OF SECTION 23, T.39 S., R. 9 E., W.M., KLAMATH COUNTY, OREGON.
2. BASIS OF BEARINGS IS OREGON STATE PLANE COORDINATE SYSTEM, SOUTH ZONE. ALL DISTANCES ARE GRID. DIVIDE DISTANCES SHOWN BY 0.99985 TO OBTAIN GROUND DISTANCES.

DESCRIPTION OF EASEMENT



A 1.05 ACRE PARCEL OF LAND FOR THE AS-BUILT LOCATION OF A NATURAL GAS PIPELINE, BEING A STRIP OF LAND 35.0 FEET WIDE LYING 15.0 FEET TO THE LEFT OF AND 20.0 FEET TO THE RIGHT OF THE FOLLOWING DESCRIBED LINE:

BEING A PORTION OF THAT CERTAIN PARCEL OF LAND DESCRIBED BY DOCUMENT RECORDED IN VOLUME M94 OF DEEDS AT PAGE 11622, RECORDED IN THE OFFICIAL RECORDS OF SAID KLAMATH COUNTY.

BEGINNING AT A POINT ON THE EAST LINE OF THE SOUTHEAST QUARTER OF SAID SECTION 23, FROM WHENCE THE NORTHEAST CORNER OF SAID SECTION 23, AS SAID CORNER IS SHOWN ON KLAMATH COUNTY SURVEY NO. 4789, BEARS N.00°52'34"E., A DISTANCE OF 2072.37 FEET, THENCE FROM SAID POINT OF BEGINNING, LEAVING SAID EAST LINE, N.86°34'08"W. 1304.45 FEET TO A POINT ON THE EAST RIGHT-OF-WAY LINE OF HOMEDALE ROAD, 60.0 FEET WIDE, THE POINT OF TERMINATION OF THIS DESCRIPTION, FROM WHENCE THE NORTH QUARTER CORNER OF SAID SECTION 23, AS SAID CORNER IS SHOWN ON KLAMATH COUNTY SURVEY NO. 4789, BEARS N.32°38'24"W., A DISTANCE OF 2467.54 FEET.

THE SIDELINES OF SAID STRIP SHALL BE SHORTENED OR EXTENDED SO AS TO INTERSECT WITH THE BOUNDARIES OF SAID LANDS.

TRACT NO. 0-KL-2490

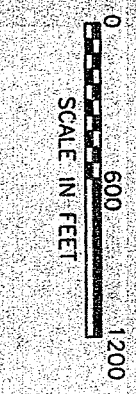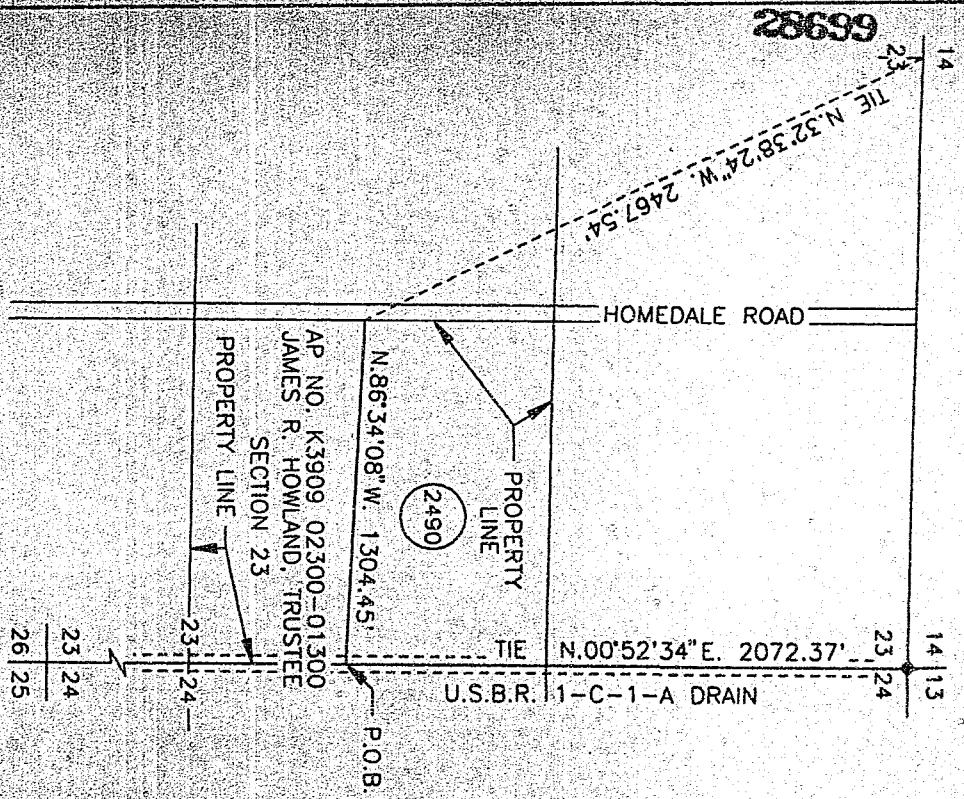

--	--	
EXHIBIT A

287CO

RECORDS

CLERK OF COUNTY

DEPARTMENT

CLERK

CLERK

287CO

HOMEVALE ROAD

THE STATE OF OREGON
COUNTY OF KLAMATH
BEFORE ME, the undersigned authority, on this 12th day of September, 1996, personally appeared Bernetha C. Letsch, County Clerk, known to me to be the person whose name is subscribed to the foregoing instrument, acknowledged to me that he executed the same for the purposes and consideration therein expressed.

STATE OF OREGON: COUNTY OF KLAMATH: ss.

Filed for record at request of PCT-Land Dept. the 12th day of September A.D. 19 96 at 11:35 o'clock AM., and duly recorded in Vol. M96 of Deeds on Page 28698.

Bernetha C. Letsch, County Clerk

By

FEE \$20.00

LAND SURVEYOR
PROFESSIONAL
REGISTERED

Doc 28698

CLERK OF COUNTY

CLERK OF COUNTY

