

24865

Volume Page 28710

When recorded, return to:

Parcel No. OR-KL-2620APN : 391019B0-00601

PGT - Land Dept.  
 P.O. Box 547  
 Redmond, OR 97756-0125

## NOTICE OF LOCATION

PACIFIC GAS TRANSMISSION COMPANY, a California corporation, pursuant to the rights conveyed to it by that certain grant of easement dated September 21, 1994 and recorded in Vol M94 of Deeds at Page 29759 in the Official Records of the County of Klamath, State of Oregon, does hereby further define the location of the strip of lands described in said grant as follows on the attached Exhibit A.

Nothing herein contained shall, or shall be construed to, modify in any way to terminate any of the rights and obligations of the parties under and by virtue of the said grant of easements in the lands therein described or the said strip thereof.

IN WITNESS WHEREOF, the undersigned has executed these presents this 20th day of August, 1996.

PACIFIC GAS TRANSMISSION COMPANY

By: W.G. Thomas  
 W.G. Thomas, Director Land RL

STATE OF OREGON }  
 } ss.  
 County of Multnomah }

On this 20th day of August, 1996 before me appeared W. G. Thomas, to me personally known, who being duly sworn, did say that he, the said W. G. Thomas is the Land Director of Pacific Gas Transmission Company, the within named Corporation, and that the said instrument was signed in behalf of said Corporation by authority of its Board of Directors, and W. G. Thomas acknowledges said instrument to be the free act and deed of said Corporation.




IN WITNESS WHEREOF, I have hereunto set my hand and affixed my official seal the day and year in this Certificate first above written.

Dino Angelosante  
 DINO ANGELOSANTE  
 NOTARY PUBLIC FOR OREGON  
 My Commission Expires: August 16, 1998



96 SEP 12 AM 1:38

28711

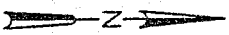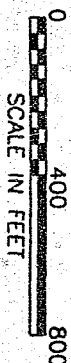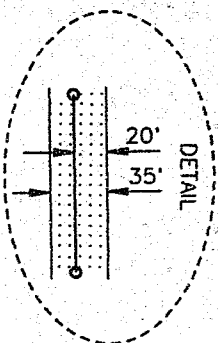

REGISTERED  
PROFESSIONAL  
LAND SURVEYOR

*Joe Fugate*

OREGON  
JANUARY 17, 1995  
JOSEPH A. FEYDER  
2692

RENEWAL DATE 12-31-97

KLAMATH COUNTY, OREGON  
SEC. 19, T-39-S, R-10-E, W.M.

NARRATIVE

1. THE PURPOSE OF THIS MAP AND NOTATIONS IS TO DEPICT AND DESCRIBE AN EASEMENT, BEING A PORTION OF THE NORTHWEST QUARTER OF SECTION 19, T.39 S., R.10 E., W.M., KLAMATH COUNTY, OREGON.
2. BASIS OF BEARINGS IS OREGON STATE PLANE COORDINATE SYSTEM, SOUTH ZONE. ALL DISTANCES ARE GRID. DIVIDE DISTANCES SHOWN BY 0.99985 TO OBTAIN GROUND DISTANCES.

DESCRIPTION OF EASEMENT


A 1.96 ACRE PARCEL OF LAND FOR THE AS-BUILT LOCATION OF A NATURAL GAS PIPELINE, BEING A STRIP OF LAND 35.0 FEET WIDE LYING 15.0 FEET TO THE LEFT OF AND 20.0 FEET TO THE RIGHT OF THE FOLLOWING DESCRIBED LINE:

BEING A PORTION OF THAT CERTAIN PARCEL OF LAND DESCRIBED BY DOCUMENT RECORDED IN VOLUME M93 OF DEEDS AT PAGE 27100, RECORDED IN THE OFFICIAL RECORDS OF SAID KLAMATH COUNTY.

BEGINNING AT A POINT ON THE EAST LINE OF THE NORTHWEST QUARTER OF SAID SECTION 19, FROM WHENCE THE CENTER QUARTER CORNER OF SAID SECTION 19, SAID CORNER MARKED BY A IRON PIN STAMPED LS-659, BEARS S.00°48'47"W., A DISTANCE OF 444.55 FEET, THENCE FROM SAID POINT OF BEGINNING, LEAVING SAID EAST LINE, N.88°31'15"W., 2436.96 FEET TO A POINT ON THE WEST RIGHT-OF-WAY LINE ON THE U.S.B.R. "A-7-N" CANAL, THE POINT OF TERMINATION OF THIS DESCRIPTION, FROM WHENCE THE WEST QUARTER CORNER OF SAID SECTION 19, AS SAID CORNER IS SHOWN ON KLAMATH COUNTY SURVEY NO. 2026, BEARS S.23°52'51"W., A DISTANCE OF 496.24 FEET.

THE SIDELINES OF SAID STRIP SHALL BE SHORTENED OR EXTENDED SO AS TO INTERSECT WITH THE BOUNDARIES OF SAID LANDS.

TRACT NO. 0-KL-2620

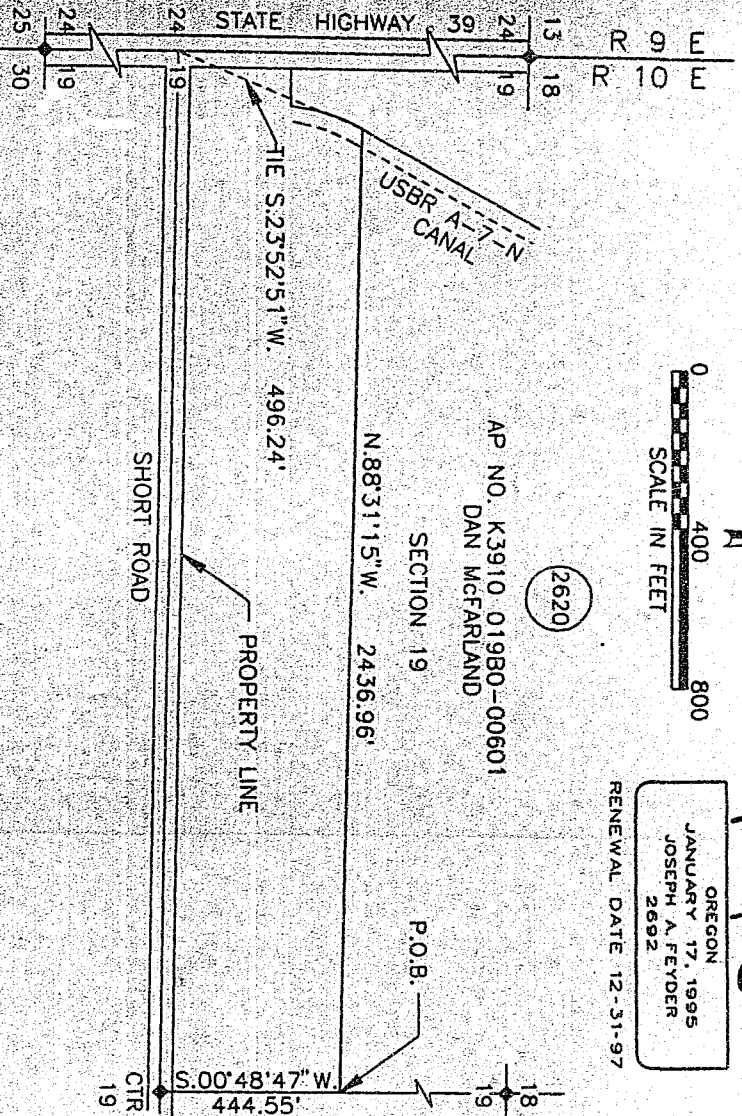

--	--	
