

24880

Vol. m96 Page 28755

When recorded, return to:

Parcel No. OR-KL-4230APN : 391100000-03800

PGT - Land Dept.

P.O. Box 547

Redmond, OR 97756-0125

NOTICE OF LOCATION

PACIFIC GAS TRANSMISSION COMPANY, a California corporation, pursuant to the rights conveyed to it by that certain grant of easement dated August 9, 1994 and recorded in Vol M94 of Deeds at Page 24443 in the Official Records of the County of Klamath, State of Oregon, does hereby further define the location of the strip of lands described in said grant as follows on the attached Exhibit A.

Nothing herein contained shall, or shall be construed to, modify in any way to terminate any of the rights and obligations of the parties under and by virtue of the said grant of easements in the lands therein described or the said strip thereof.

IN WITNESS WHEREOF, the undersigned has executed these presents this 20th day of August, 1996.

PACIFIC GAS TRANSMISSION COMPANY

By: W.G. Thomas
W.G. Thomas, Director Land

TLR

STATE OF OREGON }
 } ss.
County of Multnomah }

On this 20th day of August, 1996 before me appeared W. G. Thomas, to me personally known, who being duly sworn, did say that he, the said W. G. Thomas is the Land Director of Pacific Gas Transmission Company, the within named Corporation, and that the said instrument was signed in behalf of said Corporation by authority of its Board of Directors, and W. G. Thomas acknowledges said instrument to be the free act and deed of said Corporation.

IN WITNESS WHEREOF, I have hereunto set my hand and affixed my official seal the day and year in this Certificate first above written.

Dino Angelosante
DINO ANGELOSANTE
NOTARY PUBLIC FOR OREGON
My Commission Expires: August 16, 1998



96 SEP 12 AM 1:39

KLAMATH COUNTY, OREGON
SEC. 20, T-39-S, R-11-E, W.M.

NARRATIVE

1. THE PURPOSE OF THIS MAP AND NOTATIONS IS TO DEPICT AND DESCRIBE AN EASEMENT, BEING A PORTION OF THE SOUTHWEST QUARTER OF THE NORTHWEST QUARTER OF SECTION 20, T.39 S., R.11 E., W.M., KLAMATH COUNTY, OREGON.
2. BASIS OF BEARINGS IS OREGON STATE PLANE COORDINATE SYSTEM, SOUTH ZONE. ALL DISTANCES ARE GRID. DIVIDE DISTANCES SHOWN BY 0.99985 TO OBTAIN GROUND DISTANCES.

DESCRIPTION OF EASEMENT




A 1.17 ACRE PARCEL OF LAND FOR THE AS-BUILT LOCATION OF A NATURAL GAS PIPELINE, BEING A STRIP OF LAND 35.0 FEET WIDE LYING 15.0 FEET TO THE LEFT OF AND 20.0 FEET TO THE RIGHT OF THE FOLLOWING DESCRIBED LINE:

BEING A PORTION OF THAT CERTAIN PARCEL OF LAND DESCRIBED BY DOCUMENT RECORDED IN VOLUME M91 OF DEEDS AT PAGE 7111, RECORDED IN THE OFFICIAL RECORDS OF SAID KLAMATH COUNTY.

BEGINNING AT A POINT ON THE NORTHWESTERLY RIGHT-OF-WAY LINE OF HARPOLD ROAD, 60 FEET WIDE, FROM WHENCE THE NORTHWEST CORNER OF SAID SECTION 20 BEARS N.27°32'23"W., A DISTANCE OF 2653.13 FEET, THENCE FROM SAID POINT OF BEGINNING, LEAVING SAID RIGHT-OF-WAY LINE N.60°05'53"W., 867.62 FEET, THENCE N.54°32'22"W., 132.78 FEET, THENCE N.60°26'30"W., 450.27 FEET TO A POINT ON THE WEST LINE OF SAID SECTION 20, THE POINT OF TERMINATION OF THIS DESCRIPTION, FROM WHENCE THE NORTHWEST CORNER OF SAID SECTION 20 BEARS N.00°53'30"E., A DISTANCE OF 1621.03 FEET.

THE SIDELINES OF SAID STRIP SHALL BE SHORTENED OR EXTENDED SO AS TO INTERSECT WITH THE BOUNDARIES OF SAID LANDS.

TRACT NO. 0-KI-4230

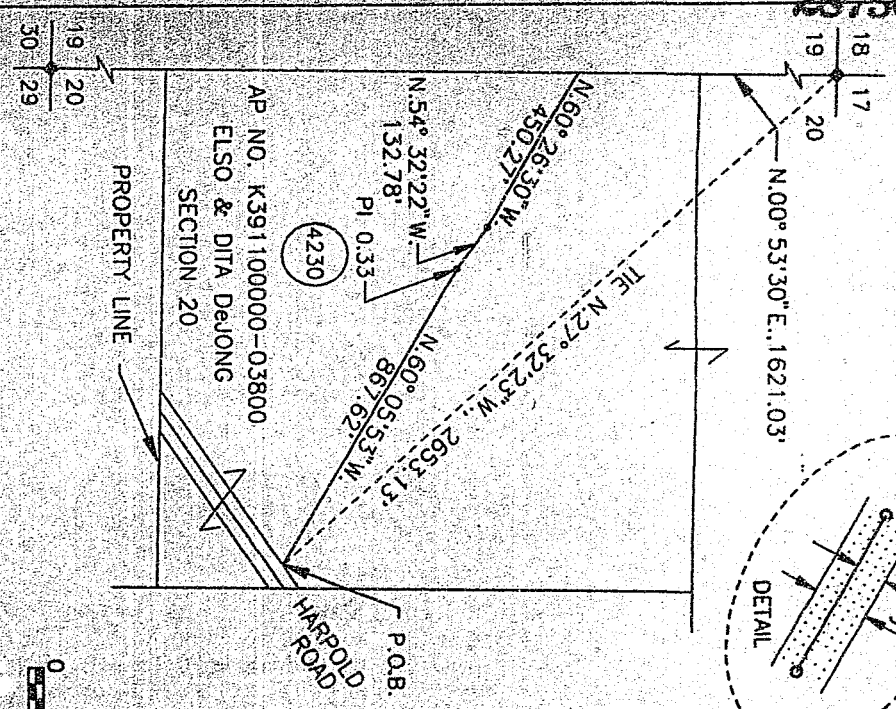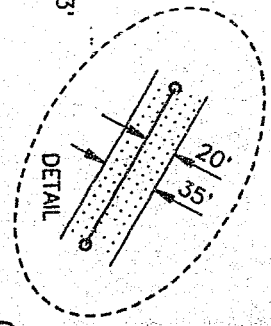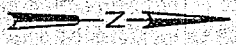

REGISTERED
PROFESSIONAL
LAND SURVEYOR
Joseph A. Feyder

OREGON
JANUARY 17, 1995
JOSEPH A. FEYDER
2592
RENEWAL DATE 12-31-97

NO.	04/19	AS-BUILT	DESCRIPTION	W.O.	DR.	CH.	APPROVALS	DATE	APR 96
W.O.	949444							SUPV	JF
DSGN	JF							DWN	RDE
CHKD	HW							CHD	HW
RIGHT-OF-WAY PLAT SHEET PIPELINE EASEMENT									
SEC.20, T-39-S, R-11-E, W.M. KLAMATH COUNTY, OREGON PACIFIC GAS TRANSMISSION COMPANY PORTLAND, OREGON									
SCALE 1" = 400'									
BILL OF MATERIAL									
SUPERSEDES									
SHEET 1 OF 1									
DRAWING NUMBER 1700-F-RW-4									
CHG 0									

RECEIVED
JAN 10 1964
U.S. DEPT. OF JUSTICE
FEDERAL BUREAU OF INVESTIGATION
WASHINGTON, D.C.

\$2

Bernetha G. Letsch, County Clerk
By

By Christy Russell

KNOWLTON COUNTY, OREGON

1940-1941
1942-1943
1944-1945
2682-2683
26

THE UNIVERSITY OF CHICAGO
LIBRARY

卷之四

MEETING

BY ORDER OF DEPUTY GOVERNOR	ORDINANCE
COUNCIL OF DISTRICTS AND TRIBAL NATIONS	HOWARD
BOARD OF INDIANS OF OREGON STATE COORDINATE COUNCIL	
611 E. WY. KENNEWICK, OREGON	
QUARTER OF THE NORTHEAST DISTRICT OF SECTION 50, T. 3 N., R. 12 E., S. 10 N.	
DEPARTMENT OF AGRICULTURE, BUREAU OF LAND MANAGEMENT	
THE PURPOSE OF THIS MAP AND NOTATION IS TO DEPICT AND	

DECLARATION OF POLYGRAPH

RECORDED THE DEEDS RETURNED TO AND FOWLER COMPANY DOCUMENT RECORDED IN AUSTIN INSTRUMENT BOOK 11, PAGE 111, BEING A PORTION OF LAND CERTAIN PARCEL OF LAND DESCRIBED BY THE

THE TERM OF AND SOO LEFT TO THE PART OF THE FOLLOWING DESCRIBED

CAS PIPELINE BEING A LINE OF LAND 120 FEET WIDE HAVING 120 FEET TO

A 11.3 ACRES PARCEL OF LAND FOR THE 120 FEET WIDE PORTION OF A LAND

[illegible]

THE UNIVERSITY OF CHICAGO PRESS

[illegible]

1970