

23475

AP NO. K3909 01600-00402
GEORGE BURY

2294

REGISTERED
PROFESSIONAL
LAND SURVEYOR
Joe Auger

OREGON
JANUARY 17, 1995
JOSEPH A. FEYDER
2692

RENEWAL DATE 12-31-97

KLAMATH COUNTY, OREGON
SEC. 16, T-39-S, R-9-E, W.M.

- NARRATIVE
1. THE PURPOSE OF THIS MAP AND NOTATIONS IS TO DEPICT AND DESCRIBE AN EASEMENT, BEING A PORTION OF THE SOUTHEAST QUARTER OF SECTION 16, T.39 S., R. 9 E., W.M., KLAMATH COUNTY, OREGON.
 2. BASIS OF BEARINGS IS OREGON STATE PLANE COORDINATE SYSTEM, SOUTH ZONE. ALL DISTANCES ARE GRID. DIVIDE DISTANCES SHOWN BY 0.99985 TO OBTAIN GROUND DISTANCES.

DESCRIPTION OF EASEMENT





A 0.73 ACRE PARCEL OF LAND FOR THE AS-BUILT LOCATION OF A NATURAL GAS PIPELINE, BEING A STRIP OF LAND 35.0 FEET WIDE LYING 15.0 FEET TO THE LEFT OF AND 20.0 FEET TO THE RIGHT OF THE FOLLOWING DESCRIBED LINE:

BEING A PORTION OF THAT CERTAIN PARCEL OF LAND DESCRIBED BY DOCUMENT RECORDED IN VOLUME M93 OF DEEDS AT PAGE 24078, RECORDED IN THE OFFICIAL RECORDS OF SAID KLAMATH COUNTY.

COMMENCING AT THE SOUTHEAST CORNER OF SAID SECTION 16, AS SAID CORNER IS SHOWN ON KLAMATH COUNTY SURVEY NO. 5286, THENCE ALONG THE EAST LINE OF THE SOUTHEAST QUARTER OF SAID SECTION 16, N.00°59.51'E, 1181.40 FEET, THENCE LEAVING SAID EAST LINE, N.84°10'29"W, 30.11 FEET TO A POINT ON THE WEST RIGHT-OF-WAY LINE OF WASHBURN WAY, AS SAID RIGHT-OF-WAY LINE IS SHOWN ON SAID KLAMATH COUNTY SURVEY NO. 5286, THE POINT OF BEGINNING OF THIS DESCRIPTION, THENCE FROM SAID POINT OF BEGINNING, LEAVING SAID WEST LINE, CONTINUING N.84°10'29"W, 281.21 FEET, THENCE N.73°12'36"W, 208.33 FEET, THENCE N.84°10'29"W, 176.41 FEET, THENCE S.83°29'32"W, 244.51 FEET TO A POINT ON THE NORTHEASTERLY RIGHT-OF-WAY LINE OF THE SOUTHERN PACIFIC RAILROAD, THE POINT OF TERMINATION OF THIS DESCRIPTION, FROM WHENCE THE SOUTHEAST CORNER OF SAID SECTION 16 BEARS, S.34°22'58"E, A DISTANCE OF 1586.48 FEET.

THE SIDELINES OF SAID STRIP SHALL BE SHORTENED OR EXTENDED SO AS TO INTERSECT WITH THE BOUNDARIES OF SAID LANDS.

(THIS DESCRIPTION INCLUDES THE U.S.B.R. "1-G" DRAIN RIGHT-OF-WAY) TRACT NO. O-KL-2320 & 2294

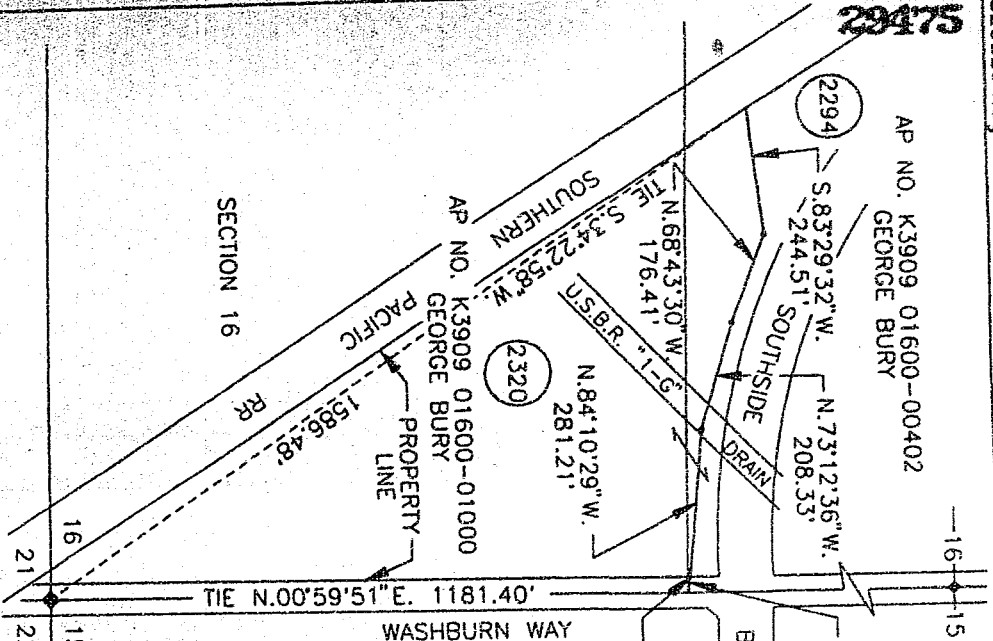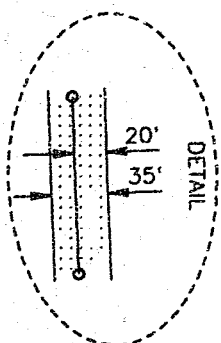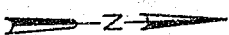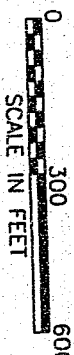

--	--	
100-443886-1

STATE OF OREGON: COUNTY OF CLATSOP.

Filed for record at request of Pacific Gas the 18th day
of September A.D., 19 36 at 9:21 o'clock A M., and duly recorded in Vol. M96,
of Deeds on Page 29474.

G. J. Letch County Clerk

FEE \$20.00

Bernetha G. Letsch County Clerk
By *Lynette Meitz*

061000Z APR 68 KMAW 11 00000

PROFESSIONAL

22

[illegible]

THE UNIVERSITY OF CHICAGO

1997, 1998, 1999, 2678, 26

— 2 —

100
 101
 102
100

27/8/2000

10

100

100

11

10

COMM. DIRECTOR
OFFICE OF ACTION, 1015 S. E. AND AVE.
CORVALLIS, OREGON 97331
DEPT. OF AGRICULTURE, THE CORRESPONDENCE
IN THE OFFICE OF THE AG AND MANAGER IS TO BE
RECEIVED

[illegible]

100-443886-1

THE FOLLOWING DISCLOSED ON NOV 10 1964 AT THE OFFICE OF THE ATTORNEY GENERAL, NEW YORK, THAT THE ABOVE NAMED INDIVIDUAL WAS BEING HELD IN CUSTODY OF THE NEW YORK STATE DEPARTMENT OF CORRECTIONS AND WAS NOT SUBJECT OF ANY

RECEIVED BY THE DIRECTOR, BUREAU OF THE ARMY, WASHINGTON, D. C. 20315
1955 JUN 10 10 10 AM
FROM: THE SECRETARY OF THE ARMY, WASHINGTON, D. C. 20315
SUBJECT: THE ARMY, WASHINGTON, D. C. 20315
1955 JUN 10 10 10 AM

1990-1991, 1991-1992, 1992-1993, 2361-2362, 23

1. The first step in the process is to identify the problem or issue that needs to be addressed. This involves gathering information and understanding the context of the problem.

[illegible]

100

100