

Parcel No. OR-KL-2410, -2444,
-2380, -2400, -2340

APN: 3909015D0-02100,
-390902300-00901
-390901500-00702
-3909 015D0-02200
-3909 01500-00700

NOTICE OF LOCATION

PACIFIC GAS TRANSMISSION COMPANY, a California corporation, pursuant to the rights conveyed to it by that certain grant of easement dated September 21, 1994 and recorded in Vol M94 of Deeds at Page 29744 in the Official Records of the County of Klamath, State of Oregon, does hereby further define the location of the strip of lands described in said grant as follows on the attached Exhibit A.

Nothing herein contained shall, or shall be construed to, modify in any way to terminate any of the rights and obligations of the parties under and by virtue of the said grant of easements in the lands therein described or the said strip thereof.

IN WITNESS WHEREOF, the undersigned has executed these presents this 3 day of September, 1996.

Return:

Pacific Gas
 P.O. Box 547
 Redmond, OR 97756-0125


PACIFIC GAS TRANSMISSION COMPANY

By: W.G. Thomas
 W.G. Thomas, Director Land TR

STATE OF OREGON }
 } ss.
 County of Multnomah }

On this 3rd day of September, 1996 before me appeared W. G. Thomas, to me personally known, who being duly sworn, did say that he, the said W. G. Thomas is the Land Director of Pacific Gas Transmission Company, the within named Corporation, and that the said instrument was signed in behalf of said Corporation by authority of its Board of Directors, and W. G. Thomas acknowledges said instrument to be the free act and deed of said Corporation.

IN WITNESS WHEREOF, I have hereunto set my hand and affixed my official seal the day and year in this Certificate first above written.

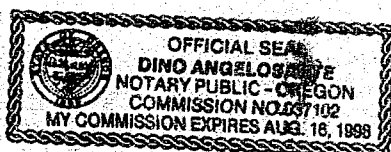


Dino Angelosante
 DINO ANGELOSANTE
 NOTARY PUBLIC FOR OREGON
 My Commission Expires: August 16, 1998

REGISTERED
PROFESSIONAL
LAND SURVEYOR

OREGON
JANUARY 17, 1992
JOSEPH A FEYDER
2692

SCALE IN EFFECT

RENEWAL DATE 12-31-97

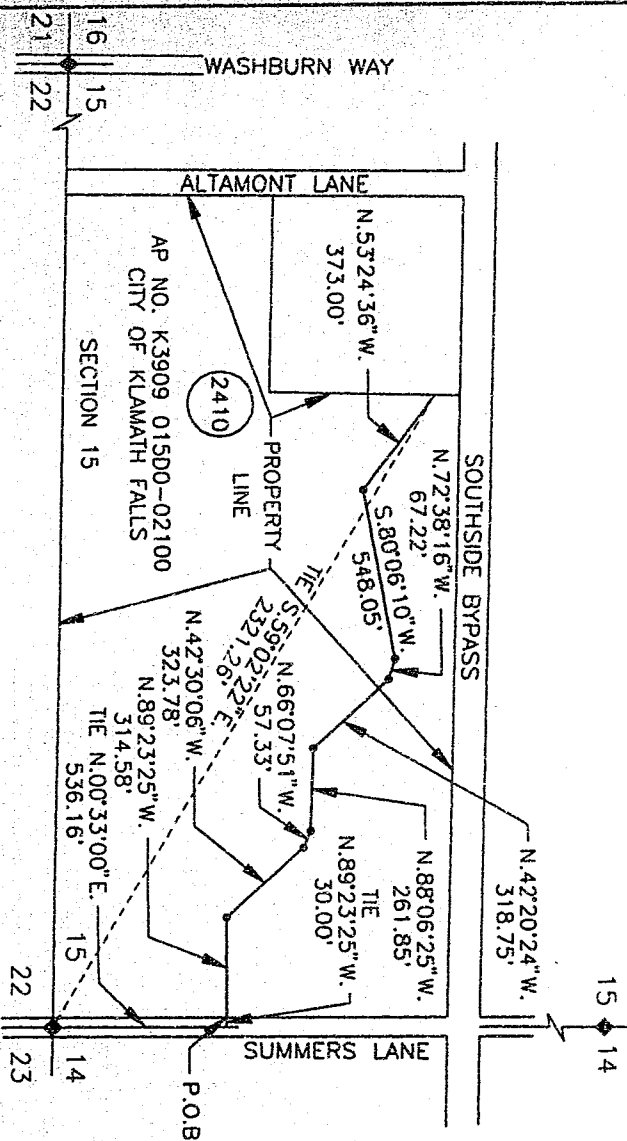

NARRATIVE

1. THE PURPOSE OF THIS MAP AND NOTATIONS IS TO DEPICT AND DESCRIBE AN EASEMENT, BEING A PORTION OF THE SOUTH HALF OF THE SOUTHEAST QUARTER OF SECTION 15, T.39 S., R. 9 E., W.M., KLAMATH COUNTY, OREGON.
2. BASIS OF BEARINGS IS OREGON STATE PLANE COORDINATE SYSTEM, SOUTH ZONE. ALL DISTANCES ARE GRID. DIVIDE DISTANCES SHOWN BY 0.999985 TO OBTAIN GROUND DISTANCES.

DESCRIPTION OF EASEMENT

A 1.82 ACRE PARCEL OF LAND FOR THE AS-BUILT LOCATION OF A NATURAL GAS PIPELINE, BEING A STRIP OF LAND 35.0 FEET WIDE LYING 15.0 FEET TO THE LEFT OF AND 20.0 FEET TO THE RIGHT OF THE FOLLOWING DESCRIBED LINE:

BEING A PORTION OF THAT CERTAIN PARCEL OF LAND DESCRIBED BY DOCUMENT RECORDED IN VOLUME 139 OF DEEDS AT PAGE 342, RECORDED IN THE OFFICIAL RECORDS OF SAID KLAMATH COUNTY.

COMMENCING AT THE SOUTHEAST CORNER OF SAID SECTION 15, AS SAID CORNER IS SHOWN ON KLAMATH COUNTY SURVEY NO.3279, THENCE ALONG THE EAST LINE OF THE SOUTHEAST QUARTER OF SAID SECTION 15, N.00°33'00"E., 536.16 FEET, THENCE LEAVING SAID EAST LINE, N.89°23'25"W 30.00 FEET TO A POINT ON THE WEST RIGHT-OF-WAY LINE OF SUMMERS LANE, 60.0 FEET WIDE. THE POINT OF BEGINNING OF THIS DESCRIPTION, THENCE FROM SAID POINT OF BEGINNING, LEAVING SAID WEST LINE, CONTINUING N.89°23'25"W. 314.58 FEET, THENCE N.42°30'06"W. 323.78 FEET, THENCE N.66°07'51"W. 57.33 FEET, THENCE N.88°06'25"W. 261.85 FEET, THENCE N.42°20'24"W. 318.75 FEET, THENCE N.72°38'16"W. 67.22 FEET, THENCE S.80°06'10"W. 548.05 FEET, THENCE N.53°24'36"W. 373.00 FEET TO A POINT ON THE WEST LINE OF THE EAST HALF OF THE SOUTHWEST QUARTER OF THE SOUTHEAST QUARTER OF SAID SECTION 15, THE POINT OF TERMINATION OF THIS DESCRIPTION, FROM WHENCE THE SOUTHEAST CORNER OF SAID SECTION 15 BEARS, S.59°02'22"E., A DISTANCE OF 2321.26 FEET.

THE SIDELINES OF SAID STRIP SHALL BE SHORTENED OR EXTENDED SO AS TO INTERSECT WITH THE BOUNDARIES OF SAID LANDS.

TRACT NO. O-KL-2410

W.O.99994

RIGHT-OF-WAY PLAT SHEET

SCALE 1" = 500

PIPELINE EASEMENT

THEY CAN'T TAKE IT ANY MORE

KLAMATH COUNTY, OREGON

PACIFIC GAS TRANSMISSION COMPANY
PORTLAND, OREGON



SHEET 1 OF 1

DRAWING NUMBER

1
2
84

CHG

29481

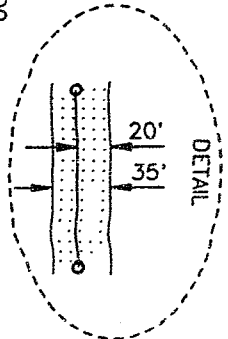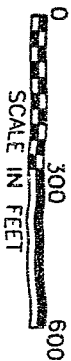

KLAMATH COUNTY, OREGON
SEC. 15, T-39-S, R-9-E, W.M.

REGISTERED
PROFESSIONAL
LAND SURVEYOR

Joe Lloyd

OREGON
JANUARY 17, 1995
JOSEPH A. FEYDER
2692

RENEWAL DATE 12-31-97

NARRATIVE

1. THE PURPOSE OF THIS MAP AND NOTATIONS IS TO DEPICT AND DESCRIBE AN EASEMENT, BEING A PORTION OF THE SOUTHWEST QUARTER OF THE SOUTHEAST QUARTER OF SECTION 15, T.39 S., R. 9 E., W.M., KLAMATH COUNTY, OREGON.
2. BASIS OF BEARINGS IS OREGON STATE PLANE COORDINATE SYSTEM, SOUTH ZONE. ALL DISTANCES ARE GRID. DIVIDE DISTANCES SHOWN BY 0.99985 TO OBTAIN GROUND DISTANCES.

DESCRIPTION OF EASEMENT


A 0.51 ACRE PARCEL OF LAND FOR THE AS-BUILT LOCATION OF A NATURAL GAS PIPELINE, BEING A STRIP OF LAND 35.0 FEET WIDE LYING 15.0 FEET TO THE LEFT OF AND 20.0 FEET TO THE RIGHT OF THE FOLLOWING DESCRIBED LINE:

BEING A PORTION OF THAT CERTAIN PARCEL OF LAND DESCRIBED BY DOCUMENT RECORDED IN VOLUME M92 OF DEEDS AT PAGE 13613, RECORDED IN THE OFFICIAL RECORDS OF SAID KLAMATH COUNTY.

BEGINNING AT A POINT ON THE EAST LINE OF THE WEST HALF OF THE SOUTHWEST QUARTER OF THE SOUTHEAST QUARTER OF SAID SECTION 15, FROM WHENCE THE SOUTHEAST CORNER OF SAID SECTION 15, AS SAID CORNER IS SHOWN ON KLAMATH COUNTY SURVEY NO. 3279, BEARS S.59°02'22"E., A DISTANCE OF 2321.26 FEET, THENCE FROM SAID POINT OF BEGINNING, LEAVING SAID EAST LINE, N.53°24'36"W., 21.86 FEET, THENCE N.70°46'45"W., 62.94 FEET, THENCE N.88°45'24"W., 369.63 FEET, THENCE S.81°56'57"W., 98.25 FEET, THENCE N.88°53'11"W., 83.21 FEET TO A POINT ON THE EAST RIGHT-OF-WAY LINE OF ALTAMONT DRIVE, 80.0 FEET WIDE, AS SHOWN ON KLAMATH COUNTY SURVEY NO. 5286, THE POINT OF TERMINATION OF THIS DESCRIPTION, FROM WHENCE THE SOUTHWEST CORNER OF SAID SECTION 15, AS SAID CORNER IS SHOWN ON KLAMATH COUNTY SURVEY NO. 5286, BEARS S.68°04'12"W., A DISTANCE OF 2941.83 FEET.

THE SIDELINES OF SAID STRIP SHALL BE SHORTENED OR EXTENDED SO AS TO INTERSECT WITH THE BOUNDARIES OF SAID LANDS.

TRACT NO. 0-KL-2400

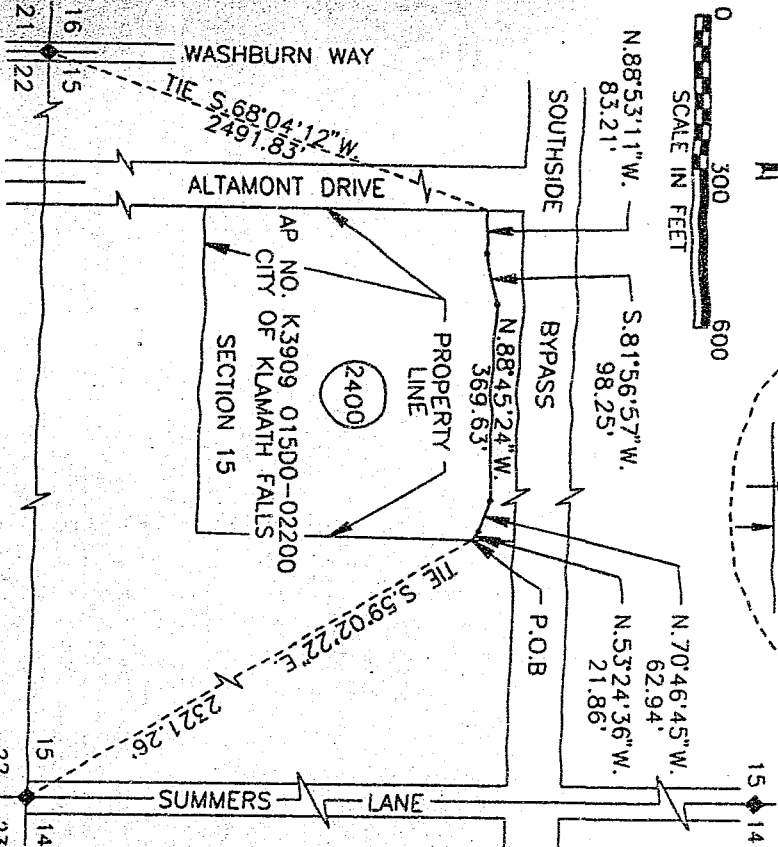

NO.	DATE	AS-BUILT	DESCRIPTION	W.O.	RDE	HW	CH.	APPROVALS
0	05/09	AS-BUILT		94944				

W.O.	949444
SUPV	
DSGN	JF
DWN	RDE
CHKD	HW
DATE	APR 96

RIGHT-OF-WAY PLAT SHEET
PIPELINE EASEMENT
SEC. 15, T-39-S, R-9-E, W.M.
KLAMATH COUNTY, OREGON
PACIFIC GAS TRANSMISSION COMPANY
PORTLAND, OREGON


SCALE	1" = 300'
BILL OF MATERIAL	
SUPSEDES	
SHEET	1 OF 1
DRAWING NUMBER	1700-F-RW-80
CHG	0

REGISTERED
PROFESSIONAL
LAND SURVEYOR

OREGON
JANUARY 17, 1928
JOSEPH A FEYDER
2092

RENEWAL DATE 12-31-97

DETAIL

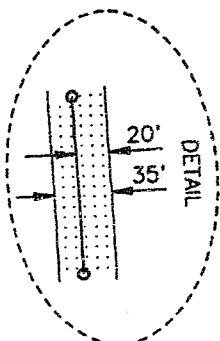

THE PURPOSE OF THIS MAP AND NOTATIONS IS TO DEPICT AND DESCRIBE AN EASEMENT, BEING A PORTION OF THE SOUTH HALF OF THE SOUTHWEST QUARTER OF SECTION 15, T.39 S., R. 9 E., W.M., KLAMATH COUNTY, OREGON.

2. BASIS OF BEARINGS IS OREGON STATE PLANE COORDINATE SYSTEM, SOUTH ZONE. ALL DISTANCES ARE GRID. DIVIDE DISTANCES SHOWN BY 0.99985 TO OBTAIN GROUND DISTANCES.

DESCRIPTION OF EASEMENT


DESCRIBED HEREIN AS A 1.31 ACRE PARCEL OF LAND FOR THE AS-BUILT LOCATION OF A NATURAL GAS PIPELINE, BEING A STRIP OF LAND 35.0 FEET WIDE LYING 15.0 FEET TO THE LEFT OF AND 20.0 FEET TO THE RIGHT OF THE FOLLOWING DESCRIBED LINE

BEING A PORTION OF THAT CERTAIN PARCEL OF LAND DESCRIBED BY
DOCUMENT RECORDED IN VOLUME M92 OF DEEDS AT PAGE 13610,
RECORDED IN THE OFFICIAL RECORDS OF SAID KILMATH COUNTY.

RECORDED IN THE S
BEGINNING AT A POINT ON THE WEST LINE OF THAT PARCEL DESCRIBED IN
VOLUME M/77 OF DEEDS AT PAGE 11674, AS SAID PARCEL IS SHOWN ON
KLAMATH COUNTY SURVEY NO. 5286, FROM WHENCE THE SOUTHWEST CORNER
OF SAID SECTION 15, AS SAID CORNER IS SHOWN ON SAID KLAMATH COUNTY
SURVEY NO. 5286, BEARS S.54°58'20"W., A DISTANCE OF 2034.70 FEET, THENCE
FROM SAID POINT OF BEGINNING, LEAVING SAID WEST LINE, N.87°17'54"W.,
115.36 FEET, THENCE S.87°23'44"W., 102.52 FEET, THENCE PARALLEL AND
15.0 FEET NORTHERLY OF THE NORTHERLY LINE OF PARCEL 1, AS SHOWN ON
SAID KLAMATH COUNTY SURVEY NO. 5286, N.89°26'21"W., 530.14 FEET TO A
POINT 15.0 FEET NORTHERLY OF "ANGLE POINT" IN THE NORTH LINE OF SAID
PARCEL 1, THENCE CONTINUING ALONG SAID PARALLEL LINE, S.88°22'02"W.,
783.80 FEET, THENCE LEAVING SAID PARALLEL LINE, N.46°23'45"W., 43.66 FEET,
THENCE N.84°10'29"W., 53.87 FEET TO A POINT ON THE EAST RIGHT-OF-WAY
LINE OF WASHBURN WAY, AS SAID RIGHT-OF-WAY IS SHOWN ON SAID
KLAMATH COUNTY SURVEY NO. 5286, THE POINT OF TERMINATION OF THIS
DESCRIPTION, FROM WHENCE THE SOUTHWEST CORNER OF SAID SECTION
15 BEARS THE FOLLOWING TWO COURSES: N.84°10'29"W., 30.11 FEET AND
S.00°59'51"W., 1181.40 FEET.

S.00°59'51" W. 110°10'00" E.
THE SIDELINES OF SAID STRIP SHALL BE SHORTENED OR EXTENDED SO
AS TO INTERSECT WITH THE BOUNDARIES OF SAID LANDS.
TRACT NO. 0-0-KL-2

TRACT NO. 0-KL-2340

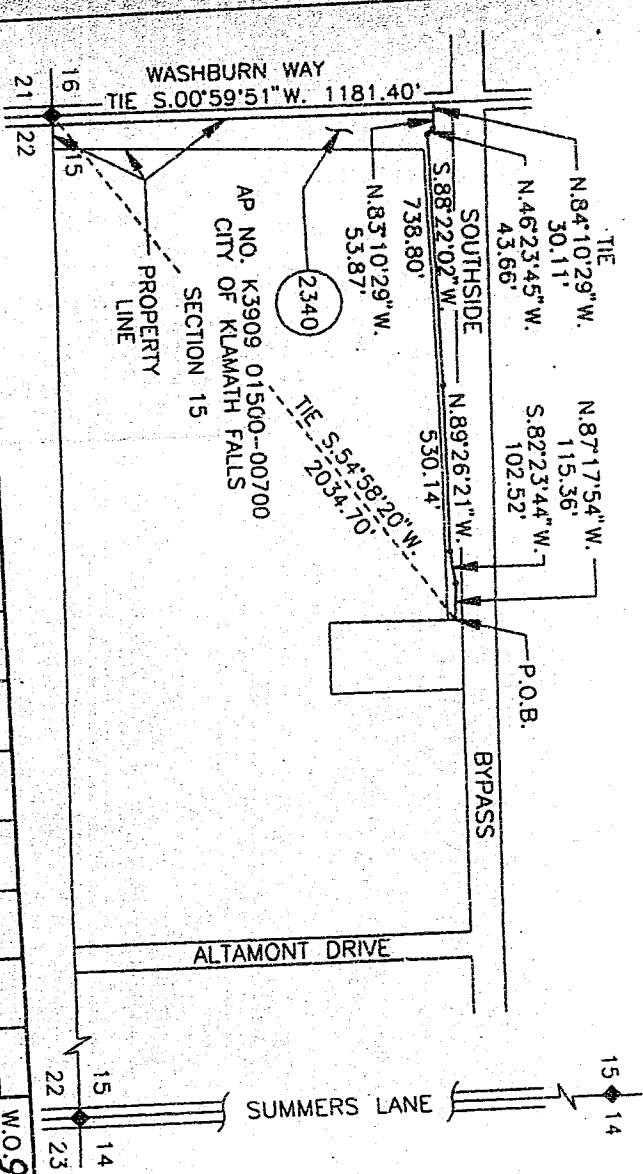[illegible]

58125

29483

STATE OF OREGON: COUNTY OF KLAMATH: ss.

Filed for record at request of Pacific Gas the 18th day
of September A.D., 19 96 at 9:21 o'clock A M., and duly recorded in Vol. M96
of Deeds on Page 29477

Bernetha G. Letsch County Clerk

By Lynette Treib

FEE \$40.00

RECORDED
INDEXED
FILED
SEP 19 1996
CLERK OF COUNTY
OF KLAMATH

John A. Treib

RECORDED
INDEXED
FILED
SEP 19 1996
CLERK OF COUNTY
OF KLAMATH

RECORDED
INDEXED
FILED
SEP 19 1996
CLERK OF COUNTY
OF KLAMATH


RECORDED
INDEXED
FILED
SEP 19 1996
CLERK OF COUNTY
OF KLAMATH

RECORDED
INDEXED
FILED
SEP 19 1996
CLERK OF COUNTY
OF KLAMATH

RECORDED
INDEXED
FILED
SEP 19 1996
CLERK OF COUNTY
OF KLAMATH

RECORDED
INDEXED
FILED
SEP 19 1996
CLERK OF COUNTY
OF KLAMATH

KLAMATH COUNTY, OREGON

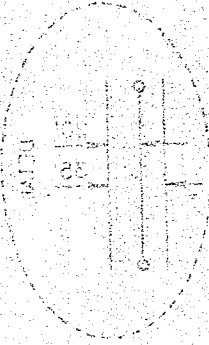

DECLARATION OF COVENANTS

THE UNDERSIGNED, PACIFIC GAS, DO HEREBY CERTIFY THAT THE FOREGOING DEED WAS PREPARED BY ME OR UNDER MY CLOSE PERSONAL SUPERVISION AND THAT THE CONTENTS OF THE FOREGOING DEED ARE TRUE AND CORRECT.

IN WITNESS WHEREOF, I have hereunto set my hand and the seal of said County at Medford, Oregon, this 18th day of September, 1996.

Bernetha G. Letsch, County Clerk

My Commission Expires: _____

NOTARIAL PUBLIC FOR THE STATE OF OREGON

My Commission Expires: _____

NOTARIAL PUBLIC FOR THE STATE OF OREGON

My Commission Expires: _____