

96 SEP 18 A9:21

Parcel No. OR-KL-2784APN : 3910 01600-01200

NOTICE OF LOCATION

PACIFIC GAS TRANSMISSION COMPANY, a California corporation, pursuant to the rights conveyed to it by that certain grant of easement dated December 30, 1994 and recorded in Vol M94 of Deeds at Page 39219 in the Official Records of the County of Klamath, State of Oregon, does hereby further define the location of the strip of lands described in said grant as follows on the attached Exhibit A.

Nothing herein contained shall, or shall be construed to, modify in any way to terminate any of the rights and obligations of the parties under and by virtue of the said grant of easements in the lands therein described or the said strip thereof.

IN WITNESS WHEREOF, the undersigned has executed these presents this 3 day of September, 1996.

PACIFIC GAS TRANSMISSION COMPANY

Return:

Pacific Gas
P.O. Box 547
Redmond, OR 97756-0125

By:


W.G. Thomas
W.G. Thomas, Director Land

TR

STATE OF OREGON }
 } ss.
County of Multnomah }


On this 3rd day of September, 1996 before me appeared W. G. Thomas, to me personally known, who being duly sworn, did say that he, the said W. G. Thomas is the Land Director of Pacific Gas Transmission Company, the within named Corporation, and that the said instrument was signed in behalf of said Corporation by authority of its Board of Directors, and W. G. Thomas acknowledges said instrument to be the free act and deed of said Corporation.

IN WITNESS WHEREOF, I have hereunto set my hand and affixed my official seal the day and year in this Certificate first above written.

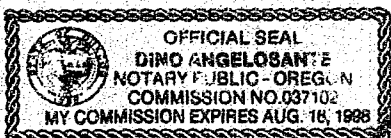

Dino Angelosante
DINO ANGELOSANTE
NOTARY PUBLIC FOR OREGON
My Commission Expires: August 16, 1998

29489

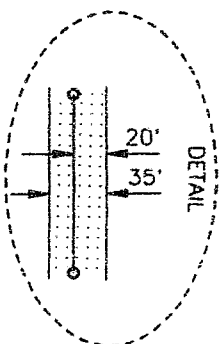


KLAMATH COUNTY, OREGON
SEC. 16, T-39-S, R-10-E, W.M.

REGISTERED
PROFESSIONAL
LAND SURVEYOR

Joseph A. Feyder

OREGON
JANUARY 17, 1995
JOSEPH A. FEYDER
2692

RENEWAL DATE 12-31-97

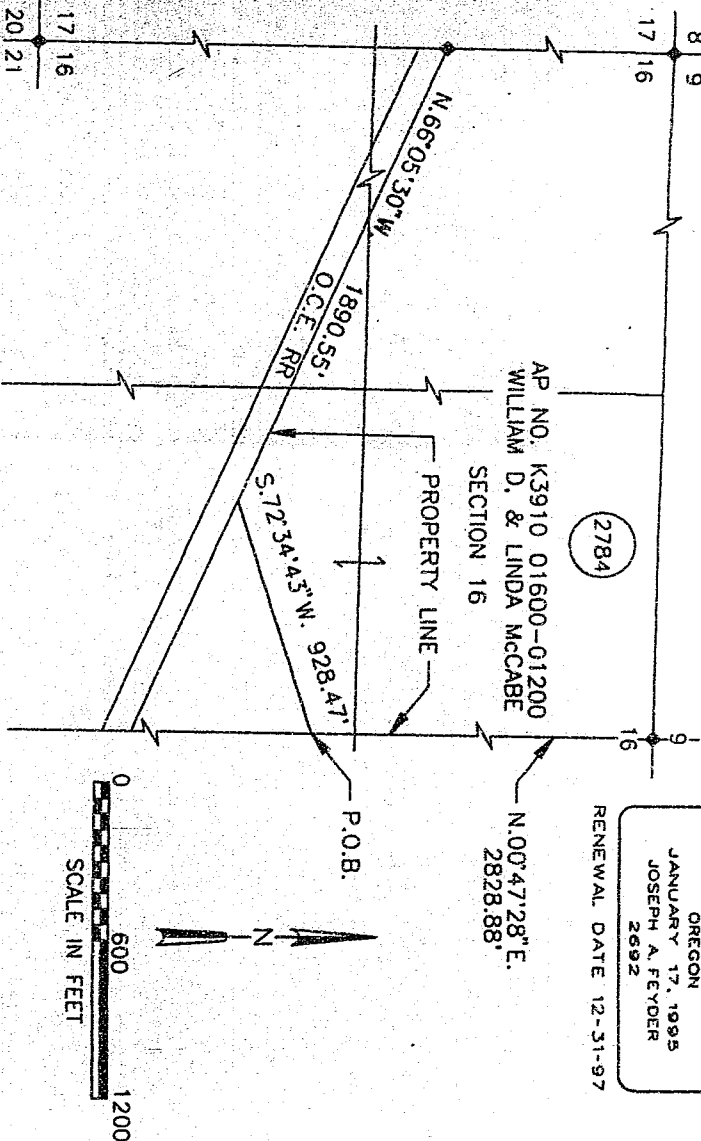

NARRATIVE

1. THE PURPOSE OF THIS MAP AND NOTATIONS IS TO DEPICT AND DESCRIBE AN EASEMENT, BEING A PORTION OF THE NORTHEAST QUARTER OF THE SOUTHWEST QUARTER OF SECTION 16, T.39 S., R.10 E., W.M., KLAMATH COUNTY, OREGON.

2. BASIS OF BEARINGS IS OREGON STATE PLANE COORDINATE SYSTEM, SOUTH ZONE. ALL DISTANCES ARE GRID. DIVIDE DISTANCES SHOWN BY 0.99985 TO OBTAIN GROUND DISTANCES.

DESCRIPTION OF EASEMENT

A 0.75 ACRE PARCEL OF LAND FOR THE AS-BUILT LOCATION OF A NATURAL GAS PIPELINE, BEING A STRIP OF LAND 35.0 FEET WIDE LYING 15.0 FEET TO THE LEFT OF AND 20.0 FEET TO THE RIGHT OF THE FOLLOWING DESCRIBED LINE:

BEING A PORTION OF THAT CERTAIN PARCEL OF LAND DESCRIBED BY DOCUMENT RECORDED IN VOLUME M94 OF DEEDS AT PAGE 19810, RECORDED IN THE OFFICIAL RECORDS OF SAID KLAMATH COUNTY.

BEGINNING AT A POINT ON THE EAST LINE OF THE NORTHEAST QUARTER OF THE SOUTHWEST QUARTER OF SAID SECTION 16, FROM WHENCE THE NORTH QUARTER CORNER OF SAID SECTION 16, AS SAID CORNER IS SHOWN ON KLAMATH COUNTY SURVEY NO. 4083, BEARS N.00°47'28\"/>

THE SIDELINES OF SAID STRIP SHALL BE SHORTENED OR EXTENDED SO AS TO INTERSECT WITH THE BOUNDARIES OF SAID LANDS.

TRACT NO. 0-KL-2784

W.O. 949444									
SUPV									
DSCN JF									
DWN RDE									
CHKD HW									
DATE APR 96									
RIGHT-OF-WAY PLAT SHEET									
PIPELINE EASEMENT									
SEC. 16, T-39-S, R-10-E, W.M.									
KLAMATH COUNTY, OREGON									
PACIFIC GAS TRANSMISSION COMPANY									
PORTLAND, OREGON									
SCALE 1" = 600'									
BILL OF MATERIAL									
SUPERSEDES									
SHEET 1 OF 1									
DRAWING NUMBER									
1700-F-RW-54									
CHG									
0									

29490

Filed for record at request of Pacific Gas the 18th day
of September A.D., 19 96 at 9:21 o'clock A M., and duly recorded in Vol. M96
of Deeds on Page 29488

FEE \$20.00

Bernetha G. Letsch County Clerk

By Lynette Freilag

100-730 STATION TRAIN

W. J. O'NEILL

1997, 1998, 1999, 2678, 26

[illegible]

Handwritten signature

100

THE UNIVERSITY OF CHICAGO

1998, 1999, 2000, 2679, 26

1998, 1999, 2000, 2679, 26

1

On 11/11/73, the following information was received from the Bureau of the FBI, New York City, regarding the above captioned case:

THE COURT OF COMMONS HAS REPORTED THAT THE HOUSE OF LORDS HAVE ORDERED THAT THE HOUSE OF COMMONS SHOULD BE KEPT OPEN FOR THE PURPOSE OF RECEIVING PETITIONS AND ANSWERING QUESTIONS.

1. The first step is to identify the problem or question that needs to be answered. This involves understanding the context and the specific requirements of the task.

1. The first part of the document discusses the importance of maintaining accurate records of all transactions and activities. It emphasizes the need for transparency and accountability in financial reporting.

2. The second part of the document outlines the various methods and techniques used to collect and analyze data. It includes a detailed description of the experimental procedures and the statistical analysis performed.

3. The third part of the document presents the results of the study. It includes a series of tables and graphs that illustrate the findings of the research.

4. The fourth part of the document discusses the implications of the findings and provides recommendations for future research. It also includes a conclusion that summarizes the main points of the study.

5. The fifth part of the document contains a list of references and a list of figures. The references include a list of books, articles, and other sources used in the study. The figures include a list of tables and graphs that are included in the document.

[illegible]

Journal of Management Education 30(6)br/>© The Author(s)
10.1177/0095647206289111
<http://jme.sagepub.com>

[illegible]