

Parcel No. OR-KL-4132, -4122
 APN : 3911V0000-04500, -04800

NOTICE OF LOCATION

PACIFIC GAS TRANSMISSION COMPANY, a California corporation, pursuant to the rights conveyed to it by that certain grant of easement dated March 15, 1994 and recorded in Vol M95 of Deeds at Page 5799 in the Official Records of the County of Klamath, State of Oregon, does hereby further define the location of the strip of lands described in said grant as follows on the attached Exhibit A.

Nothing herein contained shall, or shall be construed to, modify in any way to terminate any of the rights and obligations of the parties under and by virtue of the said grant of easements in the lands therein described or the said strip thereof.

IN WITNESS WHEREOF, the undersigned has executed these presents this 3 day of September, 1996.

Return:

Pacific Gas
 P.O. Box 547
 Redmond, OR 97756-0125


PACIFIC GAS TRANSMISSION COMPANY

By W.G. Thomas
 W.G. Thomas, Director Land TR

STATE OF OREGON }
 } ss.
 County of Multnomah }


On this 3rd day of September, 1996 before me appeared W. G. Thomas, to me personally known, who being duly sworn, did say that he, the said W. G. Thomas is the Land Director of Pacific Gas Transmission Company, the within named Corporation, and that the said instrument was signed in behalf of said Corporation by authority of its Board of Directors, and W. G. Thomas acknowledges said instrument to be the free act and deed of said Corporation.

IN WITNESS WHEREOF, I have hereunto set my hand and affixed my official seal the day and year in this Certificate first above written.

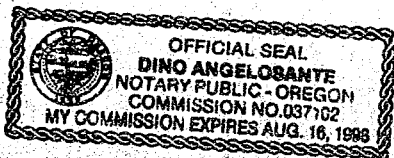

Dino Angelosante
 DINO ANGELOSANTE
 NOTARY PUBLIC FOR OREGON
 My Commission Expires: August 16, 1998

29517

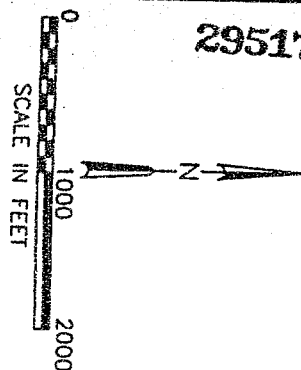

REGISTERED
PROFESSIONAL
LAND SURVEYOR

Joe Ferguson
OREGON
JANUARY 17, 1993
JOSEPH A. FEYDER
2692

RENEWAL DATE 12-31-97

4132

AP NO. K3911V0000-04500
TERRI HUNT STEWART
SECTION 13

KLAMATH COUNTY, OREGON
SEC. 13, T-39-S, R-11 1/2-E, W.M.

NARRATIVE

1. THE PURPOSE OF THIS MAP AND NOTATIONS IS TO DEPICT AND DESCRIBE AN EASEMENT, BEING A PORTION OF THE SOUTH HALF OF SECTION 13, T.39 S., R.11-1/2 E., W.M., KLAMATH COUNTY, OREGON.
2. BASIS OF BEARINGS IS OREGON STATE PLANE COORDINATE SYSTEM, SOUTH ZONE. ALL DISTANCES ARE GRID. DIVIDE DISTANCES SHOWN BY 0.99985 TO OBTAIN GROUND DISTANCES.


DESCRIPTION OF EASEMENT

A 4.49 ACRE PARCEL OF LAND FOR THE AS-BUILT LOCATION OF A NATURAL GAS PIPELINE, BEING A STRIP OF LAND 35.0 FEET WIDE LYING 15.0 FEET TO THE LEFT OF AND 20.0 FEET TO THE RIGHT OF THE FOLLOWING DESCRIBED LINE:

BEING A PORTION OF THAT CERTAIN PARCEL OF LAND DESCRIBED BY DOCUMENT RECORDED IN VOLUME M93 OF DEEDS AT PAGE 34299, RECORDED IN THE OFFICIAL RECORDS OF SAID KLAMATH COUNTY.

BEGINNING AT A POINT ON THE EAST LINE OF SAID SECTION 13, FROM WHENCE THE SOUTHEAST CORNER OF SAID SECTION 13 BEARS S.00°41'22"W., A DISTANCE OF 736.61 FEET, SAID CORNER MARKED BY A BRASS CAP MONUMENT AS PER KLAMATH COUNTY SURVEY NO. 1570, THENCE FROM SAID POINT OF BEGINNING, LEAVING SAID EAST LINE, N.84°19'48"W., 125.88 FEET, THENCE S.66°38'39"W., 1300.55 FEET, THENCE S.87°09'23"W., 676.88 FEET, THENCE N.88°18'56"W., 1607.75 FEET, THENCE N.71°22'37"W., 53.92 FEET, THENCE N.58°15'06"W., 503.28 FEET, THENCE N.56°33'31"W., 238.42 FEET, THENCE N.67°14'00"W., 81.01 FEET, THENCE S.77°22'11"W., 995.39 FEET, TO A POINT ON THE WEST LINE OF SAID SECTION 13, THE POINT OF TERMINATION OF THIS DESCRIPTION, FROM WHENCE THE SOUTHWEST CORNER OF SAID SECTION 13 BEARS S.00°54'36"W., A DISTANCE OF 388.42 FEET, SAID CORNER MARKED BY A KLAMATH COUNTY SURVEY BRASS CAP MONUMENT.

THE SIDELINES OF SAID STRIP SHALL BE SHORTENED OR EXTENDED SO AS TO INTERSECT WITH THE BOUNDARIES OF SAID LANDS.

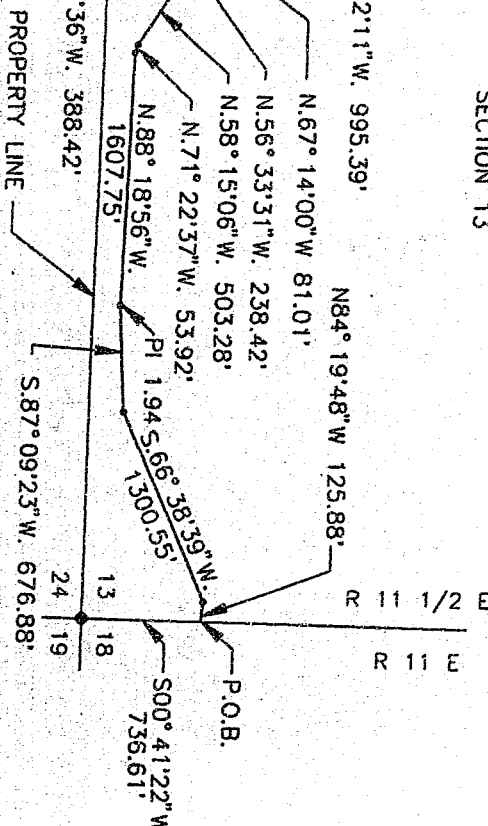

TRACT NO. 0-KL-4132

RIGHT-OF-WAY PLAT SHEET
PIPELINE EASEMENT

SCALE 1" = 1000'
BILL OF MATERIAL

SEC. 13, T-39-S, R-11 1/2-E, W.M.
KLAMATH COUNTY, OREGON
PACIFIC GAS TRANSMISSION COMPANY
PORTLAND, OREGON

SUPPERSEDES
SHEET 1 OF 1

NO. DATE AS-BUILT

DESCRIPTION

DRAWING NUMBER

CHG

NO.

DATE

DESCRIPTION

APPROVALS

DATE

DATE

NO.

DATE

DESCRIPTION

APPROVALS

DATE

DATE

De Vries

RENEWAL DATE 12-31-97

SEC. 14, T-39-S, R-11 1/2 E, W.M.

and

1. THE PURPOSE OF THIS MAP AND NOTATIONS IS TO DEPICT AND DESCRIBE AN EASEMENT, BEING A PORTION OF THE SOUTHEAST QUARTER OF THE SOUTHEAST QUARTER OF SECTION 14, T.39 S., R.11-1/2 E., W.M., KLAMATH COUNTY, OREGON.


2. BASIS OF BEARINGS IS OREGON STATE PLANE COORDINATE SYSTEM, SOUTH ZONE. ALL DISTANCES ARE GRID. DIVIDE DISTANCES SHOWN BY 0.99985 TO OBTAIN GROUND DISTANCES.



A 0.47 ACRE PARCEL OF LAND FOR THE AS-BUILT LOCATION OF A NATURAL GAS PIPELINE, BEING A STRIP OF LAND 35.0 FEET WIDE LYING 15.0 FEET TO THE LEFT OF AND 20.0 FEET TO THE RIGHT OF THE FOLLOWING DESCRIBED LINE:

BEING A PORTION OF THAT CERTAIN PARCEL OF LAND DESCRIBED BY DOCUMENT RECORDED IN VOLUME M93 OF DEEDS AT PAGE 34299, RECORDED IN THE OFFICIAL RECORDS OF SAID KLAMATH COUNTY.

BEGINNING AT A POINT ON THE EAST LINE OF SECTION 14, FROM WHENCE THE SOUTHEAST CORNER OF SAID SECTION 14 BEARS S.00° 54'36" W., A DISTANCE OF 388.42 FEET, SAID CORNER MARKED BY A KLAMATH COUNTY SURREY BRASS CAP MONUMENT, THENCE FROM SAID POINT OF BEGINNING, LEAVING SAID EAST LINE, S.77° 22'11" W., 64.21 FEET, THENCE S.64° 36'36" W., 473.93 FEET TO A POINT ON THE SOUTH LINE OF SAID SECTION 14, THE POINT OF TERMINATION OF THIS DESCRIPTION, FROM WHENCE THE SOUTHEAST CORNER OF SAID SECTION 14 BEARS S.88° 18'38" E., A DISTANCE OF 422.67 FEET.

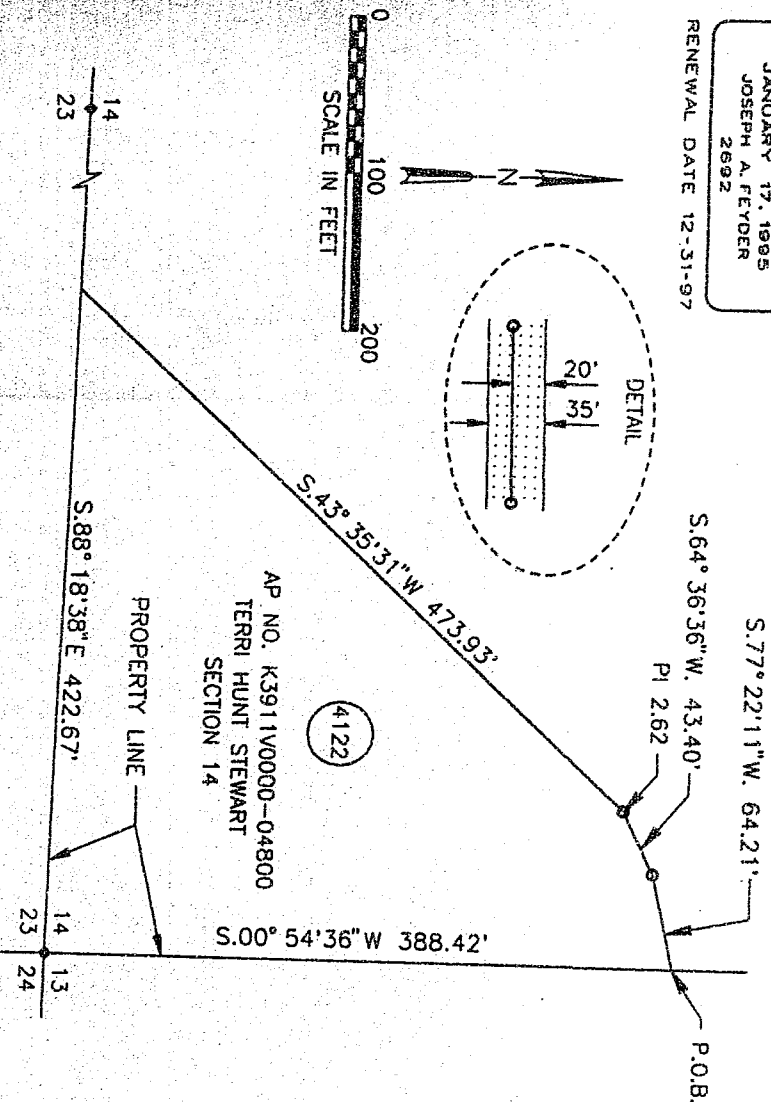THE SIDELINES OF SAID STRIP SHALL BE SHORTENED OR EXTENDED SO AS TO INTERSECT WITH THE BOUNDARIES OF SAID LANDS.



TRACT NO. O-KL-4122									
SCALE 1" = 100'									
BILL OF MATERIAL									
SUPERSEDES									
SHEET 1 OF 1									
DRAWING NUMBER 1700-F-RW-12					CHG 0				
SEC. 14, T-39-S, R-11 1/2-E, W.M. KLAMATH COUNTY, OREGON PACIFIC GAS TRANSMISSION COMPANY PORTLAND, OREGON									
RIGHT-OF-WAY PLAT SHEET PIPELINE EASEMENT									
W.O. 949444									
SUPV									
DSGN JF									
DWN RDE									
CHKD HW									
DATE MAR 96									
RECORD OF APPROVALS AND CHANGES									
NO.	DATE	AS-BUILT	DESCRIPTION	W.O.	RDE	HW	CH.	APPROVALS	
10	04/19	AS-BUILT		949444					
									


STATE OF OREGON: COUNTY OF KLAMATH: ss.

Filed for record at request of PGT the 18th day
of Sept A.D., 19 96 at 9:21 o'clock A M., and duly recorded in Vol. M96
of Deeds on Page 29516

FEE

\$25.00

Bernetha O. Letsch County Clerk
By Dyanette Drury

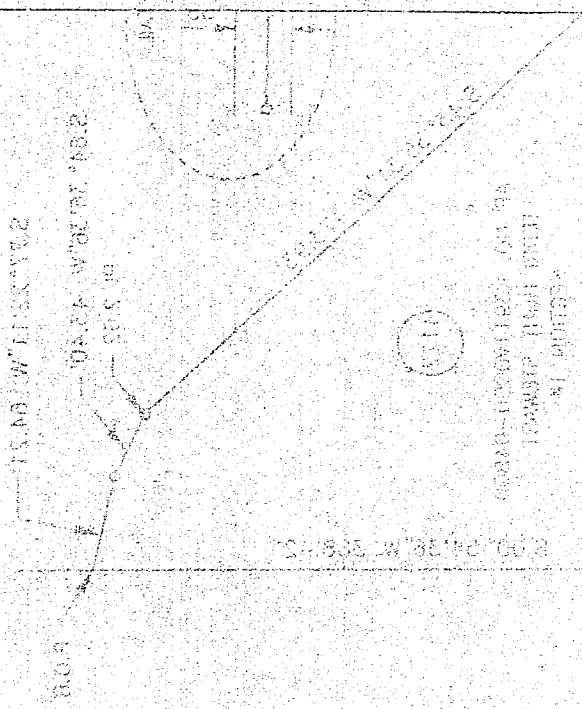

SECTION 1-36-2-6-11-13-14-15-2585-