

Parcel No: 2804
APN: 391001600-1300

NOTICE OF LOCATION

PACIFIC GAS TRANSMISSION COMPANY, a California corporation, pursuant to the rights conveyed to it by that certain grant of easement recorded June 23, 1995 in Vol M95 of Deeds at Page 16513 in the Official Records of the County of Klamath State of Oregon, does hereby further define the location of the strip of lands described in said grant as follows on the attached Exhibit A.

Nothing herein contained shall, or shall be construed to, modify in any way to terminate any of the rights and obligations of the parties under and by virtue of the said grant of easements in the lands therein described or the said strip thereof.

IN WITNESS WHEREOF, the undersigned has executed these presents this 4 day of Sept., 1996.

Return:

Pacific Gas
P.O. Box 547
Redmond, OR 97756-0125

PACIFIC GAS TRANSMISSION COMPANY


By: W.G. Thomas
W.G. Thomas, Director Land

TR

STATE OF OREGON }
County of Multnomah } ss.

On this 4th day of September, 1996 before me appeared W. G. Thomas, to me personally known, who being duly sworn, did say that he, the said W. G. Thomas is the Land Director of Pacific Gas Transmission Company, the within named Corporation, and that the said instrument was signed in behalf of said Corporation by authority of its Board of Directors, and W. G. Thomas acknowledges said instrument to be the free act and deed of said Corporation.

IN WITNESS WHEREOF, I have hereunto set my hand and affixed my official seal the day and year in this Certificate first above written.

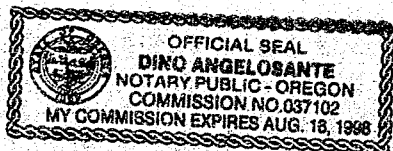

Dino Angelosante
DINO ANGELOSANTE
NOTARY PUBLIC FOR OREGON
My Commission Expires: August 16, 1998

88

29538

KLAMATH COUNTY, OREGON
SEC. 16, T-39-S, R-10-E, W.M.




NARRATIVE

REGISTERED
PROFESSIONAL
LAND SURVEYOR

Joseph A. Feyder

OREGON
JANUARY 17, 1995
JOSEPH A. FEYDER
2692

RENEWAL DATE 12-31-97

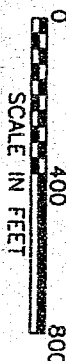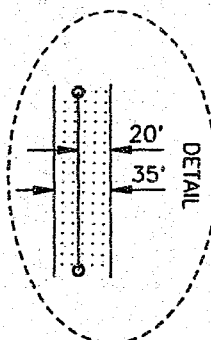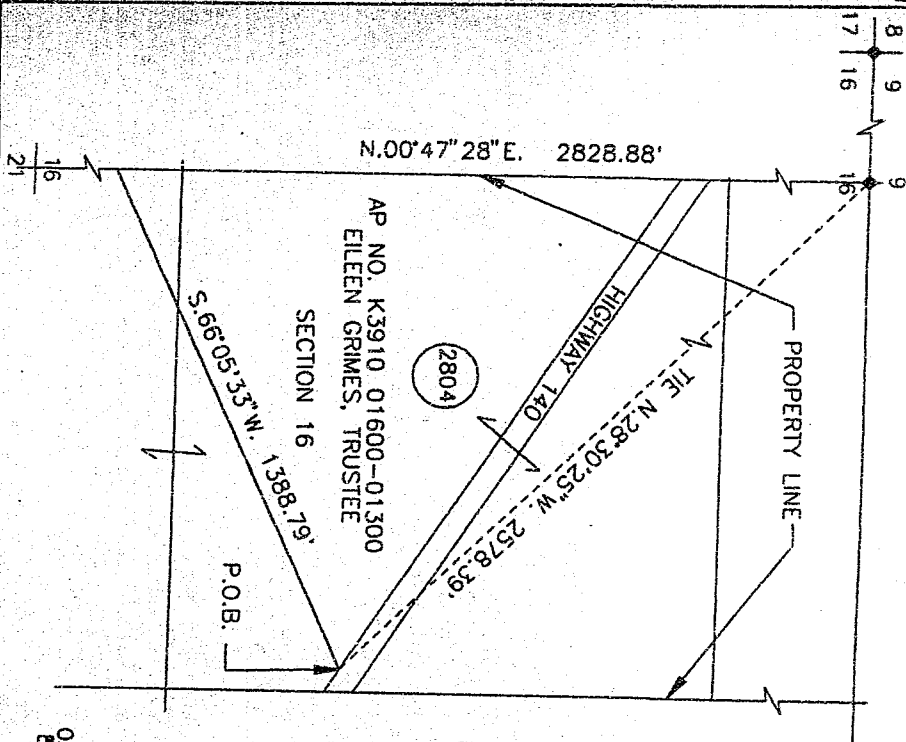

1. THE PURPOSE OF THIS MAP AND NOTATIONS IS TO DEPICT AND DESCRIBE AN EASEMENT, BEING A PORTION OF SOUTHWEST QUARTER OF THE NORTHEAST QUARTER AND THE SOUTHEAST QUARTER OF SECTION 16, T.39 S., R.10 E., W.M., KLAMATH COUNTY, OREGON.
 2. BASIS OF BEARINGS IS OREGON STATE PLANE COORDINATE SYSTEM, SOUTH ZONE. ALL DISTANCES ARE GRID. DIVIDE DISTANCES SHOWN BY 0.99985 TO OBTAIN GROUND DISTANCES.
- DESCRIPTION OF EASEMENT NUMBER ONE
- A 1.12 ACRE PARCEL OF LAND FOR THE AS-BUILT LOCATION OF A NATURAL GAS PIPELINE, BEING A STRIP OF LAND 35.0 FEET WIDE LYING 15.0 FEET TO THE LEFT OF AND 20.0 FEET TO THE RIGHT OF THE FOLLOWING DESCRIBED LINE:
- BEING A PORTION OF THAT CERTAIN PARCEL OF LAND DESCRIBED BY DOCUMENT RECORDED IN VOLUME M94 OF DEEDS AT PAGE 14836, RECORDED IN THE OFFICIAL RECORDS OF SAID KLAMATH COUNTY.
- BEGINNING AT A POINT ON THE SOUTHWESTERLY RIGHT-OF-WAY LINE OF STATE HIGHWAY 140, FROM WHENCE THE NORTH QUARTER CORNER OF SAID SECTION 16, AS SAID CORNER IS SHOWN ON KLAMATH COUNTY SURVEY NO. 4083, BEARS N.28°30'25\"/>

THE SIDELINES OF SAID STRIP SHALL BE SHORTENED OR EXTENDED SO AS TO INTERSECT WITH THE BOUNDARIES OF SAID LANDS.

TRACT NO. O-KL-2804

| |
|---|
| |
|---|

29539

2804-2.dgn 26-JUN-1996 17:22:25

8 9 9 10
17 16 16 15

2804

AP NO. K3910 01600-01300
EILEEN GRIMES, TRUSTEE
SECTION 16

REGISTERED
PROFESSIONAL
LAND SURVEYOR

Joe Snyder

OREGON
JANUARY 17, 1995
JOSEPH A. FEYDER
2692

RENEWAL DATE 12-31-97

KLAMATH COUNTY, OREGON
SEC. 16, T-39-S, R-10-E, W.M.



NARRATIVE

1. THE PURPOSE OF THIS MAP AND NOTATIONS IS TO DEPICT AND DESCRIBE AN EASEMENT, BEING A PORTION OF SOUTHWEST QUARTER OF THE NORTHEAST QUARTER AND THE SOUTHEAST QUARTER OF SECTION 16, T.39 S., R.10 E., W.M., KLAMATH COUNTY, OREGON.
2. BASIS OF BEARINGS IS OREGON STATE PLANE COORDINATE SYSTEM, SOUTH ZONE, ALL DISTANCES ARE GRID, DIVIDE DISTANCES SHOWN BY 0.99985 TO OBTAIN GROUND DISTANCES.

DESCRIPTION OF EASEMENT NUMBER TWO

A 90 SQUARE-FOOT PARCEL OF LAND FOR THE AS-BUILT LOCATION OF A NATURAL GAS PIPELINE, MORE PARTICULARLY DESCRIBED AS FOLLOWS:

BEGINNING AT A POINT ON THE EAST LINE OF THE SOUTHWEST QUARTER OF THE NORTHEAST QUARTER OF SAID SECTION 16 AND THE NORTHEASTERLY RIGHT-OF-WAY LINE OF STATE HIGHWAY 140, THENCE, FROM SAID POINT OF BEGINNING, ALONG SAID NORTHEASTERLY RIGHT-OF-WAY LINE, N.56°24'15"W, 13.95 FEET, THENCE LEAVING SAID LINE, N.66°40'29"E, 12.87 FEET TO A POINT ON THE EAST LINE OF THE SOUTHWEST QUARTER OF THE NORTHEAST QUARTER OF SAID SECTION 16, THENCE ALONG SAID EAST LINE, S.00°53'55" W, 12.82 FEET TO THE POINT OF BEGINNING OF THIS DESCRIPTION.

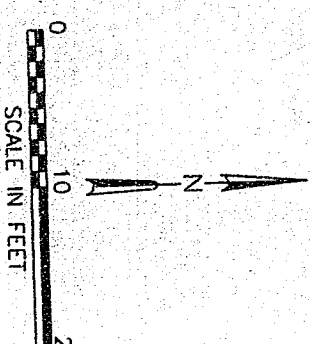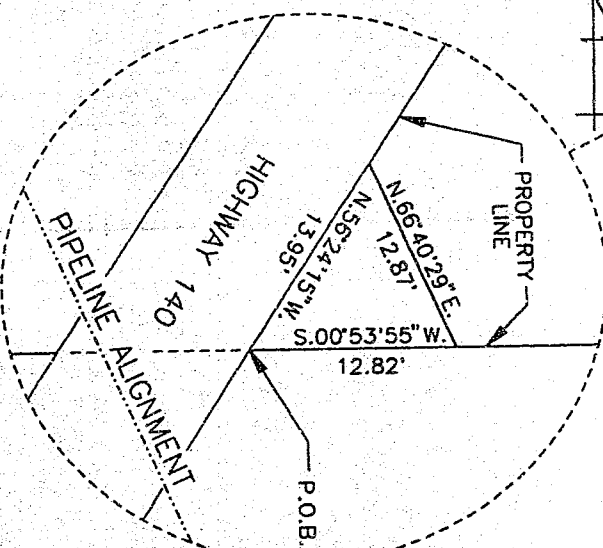

TRACT NO. 0-KL-2804

SCALE 1" = 10'

BILL OF MATERIAL

SUPERSEDES

SHEET 2 OF 2

DRAWING NUMBER

1700-F-RW-53

CHG

0

RIGHT-OF-WAY PLAT SHEET

PIPELINE EASEMENT

SEC. 16, T-39-S, R-10-E, W.M.

KLAMATH COUNTY, OREGON

PACIFIC GAS TRANSMISSION COMPANY
PORTLAND, OREGON

W.O. 949444

SUPV

DSGN JF

DWN RDE

CHKD HW

DATE MAR 96

RECORD OF APPROVALS AND CHANGES

| NO. | DATE | DESCRIPTION | W.O. | DR. | CH. | APPROVALS |
|-----|-------|-------------|--------|-----|-----|--------------------|
| 0 | 04/25 | AS-BUILT | 949444 | RDE | HW | <i>[Signature]</i> |

By Therette Miller

[illegible]