

'96 SEP 18 A9:22

Parcel No: 3980  
APN: 391001200-00200

## NOTICE OF LOCATION

PACIFIC GAS TRANSMISSION COMPANY, a California corporation, pursuant to the rights conveyed to it by that certain grant of easement recorded January 10, 1996 in Vol M96 of Deeds at Page 831 in the Official Records of the County of Klamath State of Oregon, does hereby further define the location of the strip of lands described in said grant as follows on the attached Exhibit A.

Nothing herein contained shall, or shall be construed to, modify in any way to terminate any of the rights and obligations of the parties under and by virtue of the said grant of easements in the lands therein described or the said strip thereof.

IN WITNESS WHEREOF, the undersigned has executed these presents this Sept. day of 1996.

## Return:

Pacific Gas  
P.O. Box 547  
Redmond, OR 97756-0125

PACIFIC GAS TRANSMISSION COMPANY


By: W.G. Thomas  
W.G. Thomas, Director Land

TLR

STATE OF OREGON }  
County of Multnomah } ss.

On this 18th day of September, 1996 before me appeared W. G. Thomas, to me personally known, who being duly sworn, did say that he, the said W. G. Thomas is the Land Director of Pacific Gas Transmission Company, the within named Corporation, and that the said instrument was signed in behalf of said Corporation by authority of its Board of Directors, and W. G. Thomas acknowledges said instrument to be the free act and deed of said Corporation.


IN WITNESS WHEREOF, I have hereunto set my hand and affixed my official seal the day and year in this Certificate first above written.

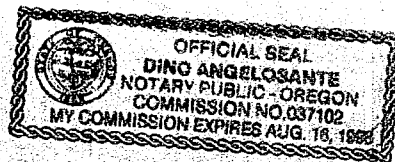

Dino Angelosante  
DINO ANGELOSANTE  
NOTARY PUBLIC FOR OREGON  
My Commission Expires: August 16, 1998

De Fred

RENEWAL DATE 12-31-97

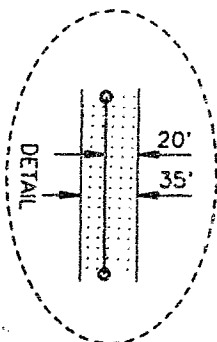

**NARRATIVE**

1. THE PURPOSE OF THIS MAP AND NOTATIONS IS TO DEPICT AND DESCRIBE AN EASEMENT, BEING A PORTION OF THE NORTHWEST QUARTER OF THE NORTHEAST QUARTER OF SECTION 12, T.39 S., R.10 E., W.M., KLAMATH COUNTY, OREGON.

2. BASIS OF BEARINGS IS OREGON STATE PLANE COORDINATE SYSTEM SOUTH ZONE. ALL DISTANCES ARE GRID. DIVIDE DISTANCES SHOWN BY 0.99985 TO OBTAIN GROUND DISTANCES.

## DESCRIPTION OF EASEMENT


A 0.14 ACRE PARCEL OF LAND FOR THE AS-BUILT LOCATION OF A NATURAL GAS PIPELINE, BEING A STRIP OF LAND 35.0 FEET WIDE LYING 15.0 FEET TO THE LEFT OF AND 20.0 FEET TO THE RIGHT OF THE FOLLOWING DESCRIBED LINE:

BEING A PORTION OF THAT CERTAIN PARCEL OF LAND DESCRIBED BY DOCUMENT RECORDED IN VOLUME M73 OF DEEDS AT PAGE 16667 RECORDED IN THE OFFICIAL RECORDS OF SAID COUNTY.

IN THE ORIGINAL RECORDS OF SAID KLAMATH COUNTY,

COMMENCING AT THE NORTHEAST CORNER OF SAID SECTION 12, SAID CORNER MARKED BY A KIAMATH COUNTY SURVEY ALUM. CAP MONUMENT STAMPED LS-658, THENCE ALONG THE NORTH LINE OF SAID SECTION 12, S.89°05'12"W., A DISTANCE OF 1296.11 FEET TO THE NORTHEAST CORNER OF THE NORTHEAST QUARTER OF THE NORTHEAST QUARTER OF SAID SECTION 12, THENCE ALONG THE EAST LINE OF THE NORTHEAST QUARTER OF THE NORTHEAST QUARTER OF SAID SECTION 12, S.01°06'36"W. A DISTANCE OF 61.35 FEET TO THE POINT OF BEGINNING OF THIS DESCRIPTION, THENCE FROM SAID POINT OF BEGINNING OF THIS LINE, N.69°31'36"W. 168.14 FEET A POINT ON THE NORTH LINE OF SAID SECTION 12, THE POINT OF TERMINATION OF THIS DESCRIPTION, FROM WHENCE THE NORTHWEST CORNER OF SAID SECTION 12 BEARS, S.89°05'12"W., A DISTANCE OF 3729.60 FEET, SAID CORNER MARKED BY A 5/8" REBAR IN A ROCK MOUND.

THE SIDELINES OF SAID STRIP SHALL BE SHORTENED OR EXTENDED SO AS TO INTERSECT WITH THE BOUNDARIES OF SAID LANDS.

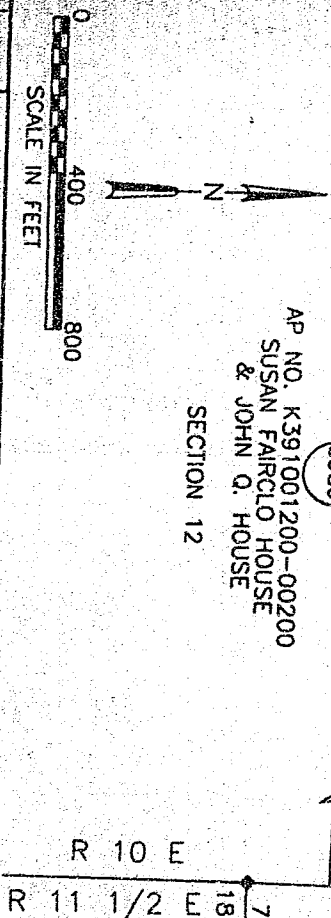[illegible]

W.O. 99999

**SUPV**

DSGN JF

DWN LC

CHKD HV

DATE APR 96

RIGHT-OF-WAY PLAT SHEET  
PIPELINE EASEMENT

SEC. 12, T-39-S, R-10-E, W.M.  
KLAMATH COUNTY, OREGON  
PACIFIC GAS TRANSMISSION COMPANY  
PORTLAND, OREGON

TRACT NO. 0-KL-3980  
SCALE 1" = 400'

## BILL OF MATERIAL

**SUPERSEDES**

SHEET 1 OF 1

1700-F-RW-26

**FEE \$20.00**

By Lynette Montag

100790 YUKIO HIRAKI  
M/3-012325 N 233

三、

1. **Introduction**  
 2. **Background**  
 3. **Methodology**  
 4. **Results**  
 5. **Discussion**  
 6. **Conclusion**  
 7. **References**  
 8. **Appendix**  
 9. **Figure 1**  
 10. **Figure 2**  
 11. **Figure 3**  
 217. **Figure 209**

1. The first step is to identify the problem. This involves understanding the symptoms and the context in which they are occurring.

[illegible][illegible]

WILLIAM W. KENNEDY (DANIEL W. KENNEDY),  
DIRECTOR OF THE HARBOR, OFFICIAL OF SEASIDE, FOR  
RECEIVED ON GENERAL SERVICE SECTION OF THE MARINE  
THE PROCEEDING IN THE ADVANCEMENT OF THE PROCEEDING