

Parcel No: 3910  
APN: 391000000-00400

## NOTICE OF LOCATION

PACIFIC GAS TRANSMISSION COMPANY, a California corporation, pursuant to the rights conveyed to it by that certain grant of easement recorded March 15, 1995 in Vol M95 of Deeds at Page 5783 in the Official Records of the County of Klamath State of Oregon, does hereby further define the location of the strip of lands described in said grant as follows on the attached Exhibit A.

Nothing herein contained shall, or shall be construed to, modify in any way to terminate any of the rights and obligations of the parties under and by virtue of the said grant of easements in the lands therein described or the said strip thereof.

IN WITNESS WHEREOF, the undersigned has executed these presents this 4 day of Sept., 1996.

## Return:

Pacific Gas  
P.O. Box 547  
Redmond, OR 97756-0125

PACIFIC GAS TRANSMISSION COMPANY

By: W.G. Thomas

W.G. Thomas, Director Land

TR


STATE OF OREGON

County of Multnomah

} ss.

On this 4<sup>th</sup> day of September, 1996 before me appeared W. G. Thomas, to me personally known, who being duly sworn, did say that he, the said W. G. Thomas is the Land Director of Pacific Gas Transmission Company, the within named Corporation, and that the said instrument was signed in behalf of said Corporation by authority of its Board of Directors, and W. G. Thomas acknowledges said instrument to be the free act and deed of said Corporation.

IN WITNESS WHEREOF, I have hereunto set my hand and affixed my official seal the day and year in this Certificate first above written.

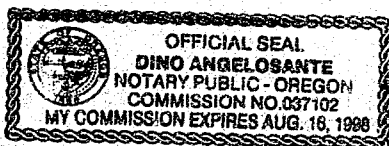

Dino Angelosante  
DINO ANGELOSANTE  
NOTARY PUBLIC FOR OREGON

My Commission Expires: August 16, 1998

29568


CLAMATH COUNTY, OREGON  
SEC. 2, T-39-S, R-10-E, W.M.

REGISTERED  
PROFESSIONAL  
LAND SURVEYOR

*Joe Fung*

OREGON  
JANUARY 17, 1985  
JOSEPH A. FEYDER  
2692

RENEWAL DATE 12-31-97

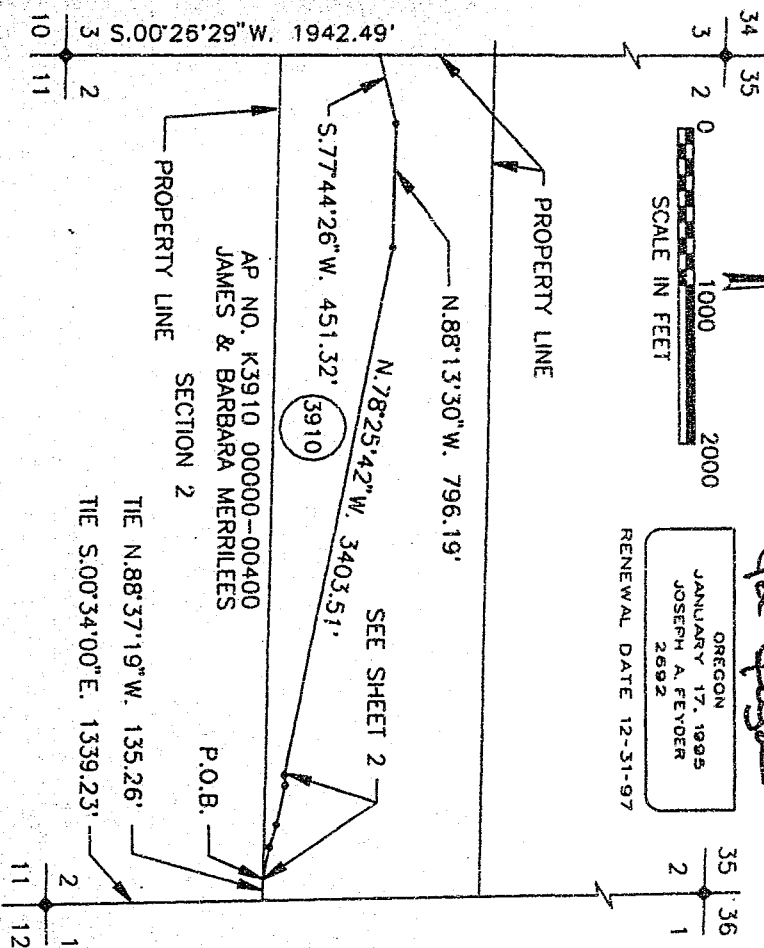


NARRATIVE



1. THE PURPOSE OF THIS MAP AND NOTATIONS IS TO DEPICT AND DESCRIBE AN EASEMENT, BEING A PORTION OF THE NORTH HALF OF THE SOUTH HALF OF SECTION 2, T.39 S., R.10 E., W.M., CLAMATH COUNTY, OREGON.
2. BASIS OF BEARINGS IS OREGON STATE PLANE COORDINATE SYSTEM, SOUTH ZONE. ALL DISTANCES ARE GRID. DIVIDE DISTANCES SHOWN BY 0.999985 TO OBTAIN GROUND DISTANCES.

DESCRIPTION OF EASEMENT

A 4.15 ACRE PARCEL OF LAND FOR THE AS-BUILT LOCATION OF A NATURAL GAS PIPELINE, BEING A STRIP OF LAND 35.0 FEET WIDE LYING 15.0 FEET TO THE LEFT OF AND 20.0 FEET TO THE RIGHT OF THE FOLLOWING DESCRIBED LINE:  
  
BEING A PORTION OF THAT CERTAIN PARCEL OF LAND DESCRIBED BY DOCUMENT RECORDED IN VOLUME M90 OF DEEDS AT PAGE 281, RECORDED IN THE OFFICIAL RECORDS OF SAID CLAMATH COUNTY.

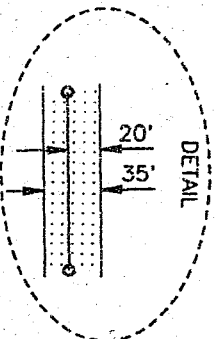

																																																																																																																																																																																																																																																																																																																																																																																																																																																																																																																																																																																																																																																																																																																																																																																																																																																																																																																																																																																																																																																																																																																																																																																																																																																																																																																																																																																																																					</
--	--	----

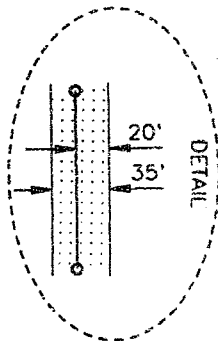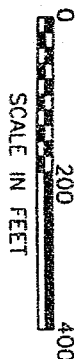~~SECRET~~ - Z - ~~SECRET~~


REGISTERED  
PROFESSIONAL  
LAND SURVEYOR

OREGON  
JANUARY 17, 1995  
JOSEPH A. FEYDER  
2692

RENEWAL DATE 12-31-97

AP NO. K39100 0000-00400  
JAMES & BARBARA MERRILEES  
SECTION 2

## SECTION 2

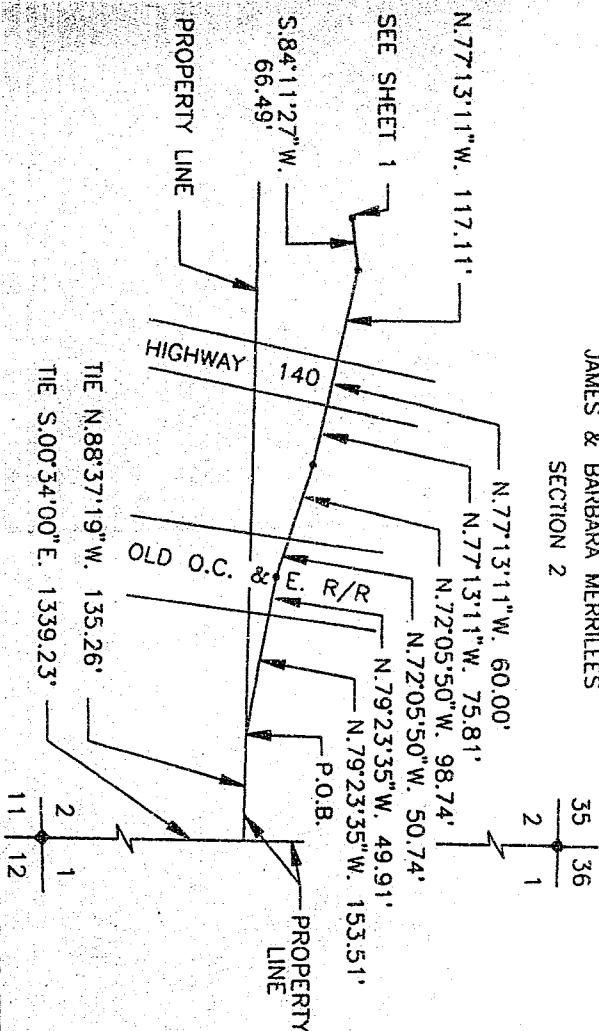

COMMENCING AT THE SOUTHEAST CORNER OF THE NORTH HALF OF THE SOUTH HALF OF SAID SECTION 2, FROM WHENCE THE SOUTHEAST CORNER OF SAID SECTION 2 BEARS S. 0°34'00"E., A DISTANCE OF 1339.23 FEET, SAID CORNER MARKED BY A 5/8" REBAR IN A ROCK MOUND, THENCE ALONG THE SOUTH LINE OF THE NORTH HALF OF THE SOUTH HALF OF SAID SECTION 2, N.88°37'19"W., A DISTANCE OF 135.26 FEET TO THE POINT OF BEGINNING OF THIS DESCRIPTION, THENCE FROM SAID POINT OF BEGINNING, LEAVING SAID SOUTH LINE, N.79°23'35"W. 153.31 FEET TO A FENCE ASSUMED TO BE THE EASTERLY RIGHT-OF-WAY LINE OF THE OLD OREGON CALIFORNIA AND EASTERN RAILWAY COMPANY (M92 DEEDS, PAGE 15208), THENCE CONTINUING N.79°23'35"W. 49.91 FEET, THENCE N.72°05'50"W. 50.74 FEET TO THE WESTERLY RIGHT-OF-WAY LINE OF SAID RAILWAY COMPANY, THENCE CONTINUING N.72°05'50"W. 98.74 FEET, THENCE N.77°13'11"W. 75.81 FEET TO A POINT ON THE EASTERLY RIGHT-OF-WAY LINE OF STATE HIGHWAY 140, 60.0 FEET WIDE, THENCE CONTINUING N.77°13'11"W. 60.00 FEET TO A POINT ON THE WESTERLY RIGHT-OF-WAY LINE OF SAID HIGHWAY 140, THENCE CONTINUING N.77°13'11"W. 117.11 FEET, THENCE S.84°11'27"W. 66.49 FEET, THENCE N.78°25'42"W. 3403.51 FEET, THENCE N.88°13'30"W. 796.19 FEET, THENCE S.77°44'26"W. 451.32 FEET TO A POINT ON THE WEST LINE OF SAID SECTION 2, THE POINT OF TERMINATION OF THIS DESCRIPTION, FROM WHENCE THE SOUTHWEST CORNER OF SAID SECTION 2 BEARS S. 0°26'29"W. A DISTANCE OF 1942.49 FEET, SAID CORNER MARKED BY A 5/8" IRON PIN IN A ROCK MOUND AS PER KLAMATH COUNTY SURVEY NO.1718.

THE SIDELINES OF SAID STRIP SHALL BE SHORTENED OR EXTENDED SO AS TO INTERSECT WITH THE BOUNDARIES OF SAID LANDS.

EXCEPTING ANY PORTION OF THE DESCRIBED STRIP OF LAND LYING WITHIN SAID OREGON CALIFORNIA AND EASTERN RAILWAY COMPANY RIGHT-OF-WAY AND SAID STATE HIGHWAY 140 RIGHT-OF-WAY.

[illegible]