

28596

16 NOV 19 21:11

Vol. m96 Page 36420

PGT  
1440 SE LAKE RD  
REDMOND OR 97758

Parcel No. O-KL-1548  
APN : 390703000-00300

## NOTICE OF LOCATION

PACIFIC GAS TRANSMISSION COMPANY, a California corporation, pursuant to the rights conveyed to it by ALDEN and STARLA GLIDDEN in that certain grant of easement recorded August 8, 1995 in Vol. M95 of Deeds at Page 20916 in the Official Records of the County of Klamath State of Oregon, does hereby further define the location of the strip of lands described in said grant as follows on the attached Exhibit A.

Nothing herein contained shall, or shall be construed to, modify in any way to terminate any of the rights and obligations of the parties under and by virtue of the said grant of easements in the lands therein described or the said strip thereof.

IN WITNESS WHEREOF, the undersigned has executed these presents this 5 day of November, 1996.


PACIFIC GAS TRANSMISSION COMPANY

By: W.G. Thomas  
W.G. Thomas, Director Land rk

STATE OF OREGON }  
County of Multnomah } ss.

On this 5<sup>th</sup> day of November, 1996 before me appeared W. G. Thomas, to me personally known, who being duly sworn, did say that he, the said W. G. Thomas is the Land Director of Pacific Gas Transmission Company, the within named Corporation, and that the said instrument was signed in behalf of said Corporation by authority of its Board of Directors, and W. G. Thomas acknowledges said instrument to be the free act and deed of said Corporation.

IN WITNESS WHEREOF, I have hereunto set my hand and affixed my official seal the day and year in this Certificate first above written.

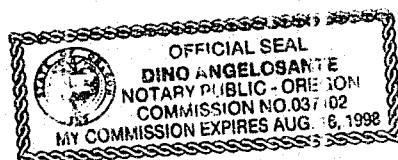

Dino Angelosante  
DINO ANGELOSANTE  
NOTARY PUBLIC FOR OREGON  
My Commission Expires: August 16, 1998

CK  
1500

KLAMATH COUNTY, OREGON  
SEC. 30, T-39-S, R-7-E, W.M.


**NARRATIVE**

PROFESSIONAL

10

2002

1000

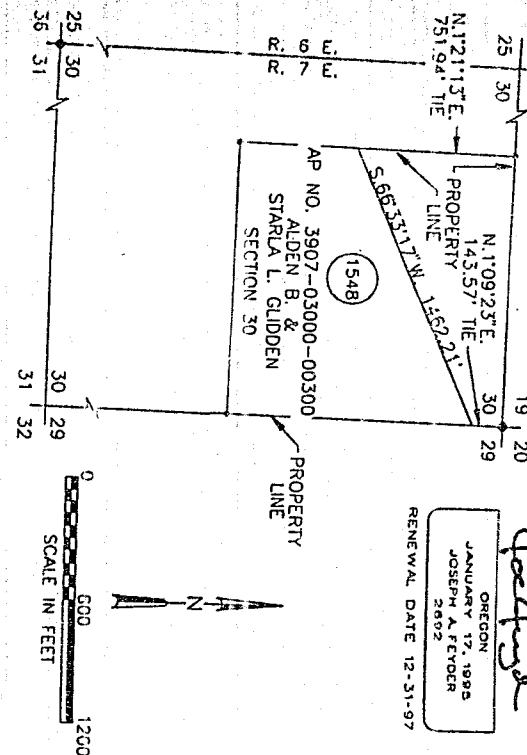

1. THE PURPOSE OF THIS MAP AND NOTATIONS IS TO DEPICT AND DESCRIBE AN EASEMENT, BEING A PORTION OF THE NORTHEAST QUARTER OF THE NORTHEAST QUARTER OF SECTION 30, T.39 S., R. 7 E., W.M., KLAMATH COUNTY, OREGON.

2. BASIS OF BEARINGS IS OREGON STATE PLANE COORDINATE SYSTEM, SOUTH ZONE. ALL DISTANCES ARE GRID. DIVIDE DISTANCES SHOWN BY 0.999985 TO OBTAIN GROUND DISTANCES.

DESCRIPTION OF EASEMENT

A 1.17 ACRE PARCEL OF LAND FOR THE AS-BUILT LOCATION OF A NATURAL GAS PIPELINE, BEING A STRIP OF LAND 35.0 FEET WIDE LYING 15.0 FEET TO THE LEFT OF AND 20.0 FEET TO THE RIGHT OF THE FOLLOWING DESCRIBED LINE:

BEING A PORTION OF THAT CERTAIN PARCEL OF LAND DESCRIBED BY DOCUMENT RECORDED IN VOLUME M79 OF DEEDS AT PAGE 24523, RECORDED IN THE OFFICIAL RECORDS OF SAID KLAMATH COUNTY.

BEGINNING AT A POINT ON THE EAST LINE OF THE NORTHEAST QUARTER OF THE NORTHEAST QUARTER OF SAID SECTION 30, FROM WHENCE THE NORTHEAST CORNER OF SAID SECTION 30, SAID CORNER MARKED BY A 1-1/2" IRON PIPE, BEARS N. 109.23° E., A DISTANCE OF 143.57 FEET, THENCE S. 4462.21 FEET TO A POINT ON THE WEST LINE, S. 66.33° 17' W., 1462.21 FEET TO A POINT ON THE WEST LINE OF THE NORTHEAST QUARTER OF THE NORTHEAST QUARTER OF SAID SECTION 30, THE POINT OF TERMINATION OF THIS DESCRIPTION, FROM WHENCE THE NORTHEAST CORNER OF THE NORTHEAST QUARTER OF THE NORTHEAST QUARTER OF SAID SECTION 30, SAID CORNER MARKED BY A 1-1/2" IRON PIPE, BEARS N. 01.21° 35' E., A DISTANCE OF 751.94 FEET.

THE SIDELINES OF SAID STRIP SHALL BE SHORTENED OR EXTENDED SO AS TO INTERSECT WITH THE BOUNDARIES OF SAID LANDS.

TO INTERSECT WITH THE BOUNDARIES OF SAID LANDS.

EXHIBIT A

INVEST NO. 0-NL-1348

SCALE 1" = 600'

# BILL OF MATERIAL

# ORIGINAL

---

## SUPERSEDES

**SHEET 1 OF**

100

**DRAWING NUMBER**

11700--F--RW-1

\_\_\_\_\_

Journal of Management Inquiry 23(1) 3-16

Journal of Management Inquiry 20(4) 409-424

100

1999, 2000, 2001, 2680, 26

**Abstract**

6379

STATE OF OREGON: COUNTY OF KLAMATH: ss

Filed for record at request of Pacific Gas Transmission the 19th day  
of November A.D., 19 96 at 1:11 o'clock P.M., and duly recorded in Vol. M96  
of Deeds on Page 36420

FEE \$15.00

Barnetha G. Letsch County Clerk  
By Kathryn Kroenke