

2552-CR9457-P-1
39-12-21-1301

COMMUNICATIONS LINE RIGHT-OF-WAY EASEMENT

20

TWS

GERALD W. SMITH, TOM W. SMITH, and JOYCE A. SMITH hereby grant to CENTURYTEL OF EASTERN OREGON, INC., dba CENTURYTEL, its successors and assigns, (hereinafter referred to as the Company), the right to construct and maintain aerial telephone and communications facilities, together with all necessary poles, anchors, guys, wires and fixtures incidental thereto, over, under, upon and across the following described property:

Return To: Affiliated Land Services, Inc.
P.O. Box 17035, Salem, OR 97305

A strip of land 10 feet in width, the centerline of said strip being contiguous to the centerline traverse of an aerial power utility pole line, as it exists, located along and adjacent to an Easterly-Westerly roadway, as it exists, situated along and adjacent to the North boundary of Parcel 1 of Partitioning Plat No. 23-92, according to the official plat thereof on file in the official records of Klamath County, Oregon.

Situated in the County of Klamath, State of Oregon, together with such additional adjacent area as may be reasonably required by the Company for placement and maintenance of down-guys and anchors supporting the Company's telephone and communications facilities placed hereunder, the location of said down-guys and anchors being as generally shown on Exhibit "A", attached hereto and made part hereof.

It is agreed that the Company, its successors and assigns, shall have access to said premises for the purposes stated, and shall be responsible for any damage to said premises by reason of any negligence on the part of said Company's employees while placing and maintaining construction, provided, however, that the Company shall have the right to clear and keep cleared trees or other obstructions which may interfere or threaten to interfere with the exercise of the Company's rights granted hereunder.

Dated: 10-24-99

Gerald W. Smith

TWS

Tom W. Smith

Joyce A. Smith

JWS

For Telephone Company:

Job No. _____

STATE OF Oregon)


COUNTY OF Klamath)

ss.

BE IT REMEMBERED, That on this 24th day of October, 1999, before me, the undersigned, a Notary Public in and for said County and State, personally appeared Tom W. Smith

the identical individual described in and who executed the within instrument and acknowledged to me that he executed the same freely and voluntarily.

IN TESTIMONY WHEREOF, I have hereunto set my hand and affixed my official seal the day and year first above written.

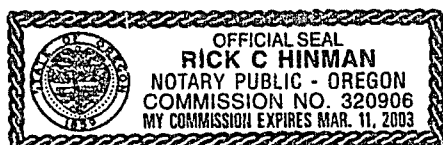

[Signature]
Notary Public in and for the State of Oregon
My Commission expires: 3-11-02

EXHIBIT A

Return To: Affiliated Lin. & Service, Inc.
P.O. Box 17035, Salem, OR 97303

Units	Actl.	Yr	SI	Unit Description	Reel #
2				A HA-R(1)(1")	
1				A HA-R(2)(2")	
12				A HC-1	
1				A NJPI-3FG6	
2				A NPE1-3	
1				A NPE2-3	
2				A PF3-5	
2				A PG9-6	
2				A PM11	
1				A PM52-1	
650				A SEAB-24	
3				W HC-1	
6				W PM52-1	
916				XX DW1-14	
650				XX SEA1-18	
620				99 A CW12-22(10W)	


HEIGHT OF ATTACHMENT = 21'
SERVICE ORDER #C0058097

CALL FOR LOCATES
1-800-332-2344

Known utility lines are shown
in approximate locations only.
All exact locations to be
determined by the contractor
during construction.

ENGR: GARY VICK
PHONE: 541-798-7568
FAC. TECH: KATHY TODD
PHONE: 541-798-3040

Title: AER CA WILLIAMS BUNN WAY	
W.O. CR9457	ACAD: CR9457C1
Ex: 2552	CR: 1776-182-2
City: KLAMATH	Twn: T39S
Drawn: GV	Rng: R12E
Redlined:	Posted: Sec: 20/21
Sht 1 of 1	Iss: 1
	Prj:

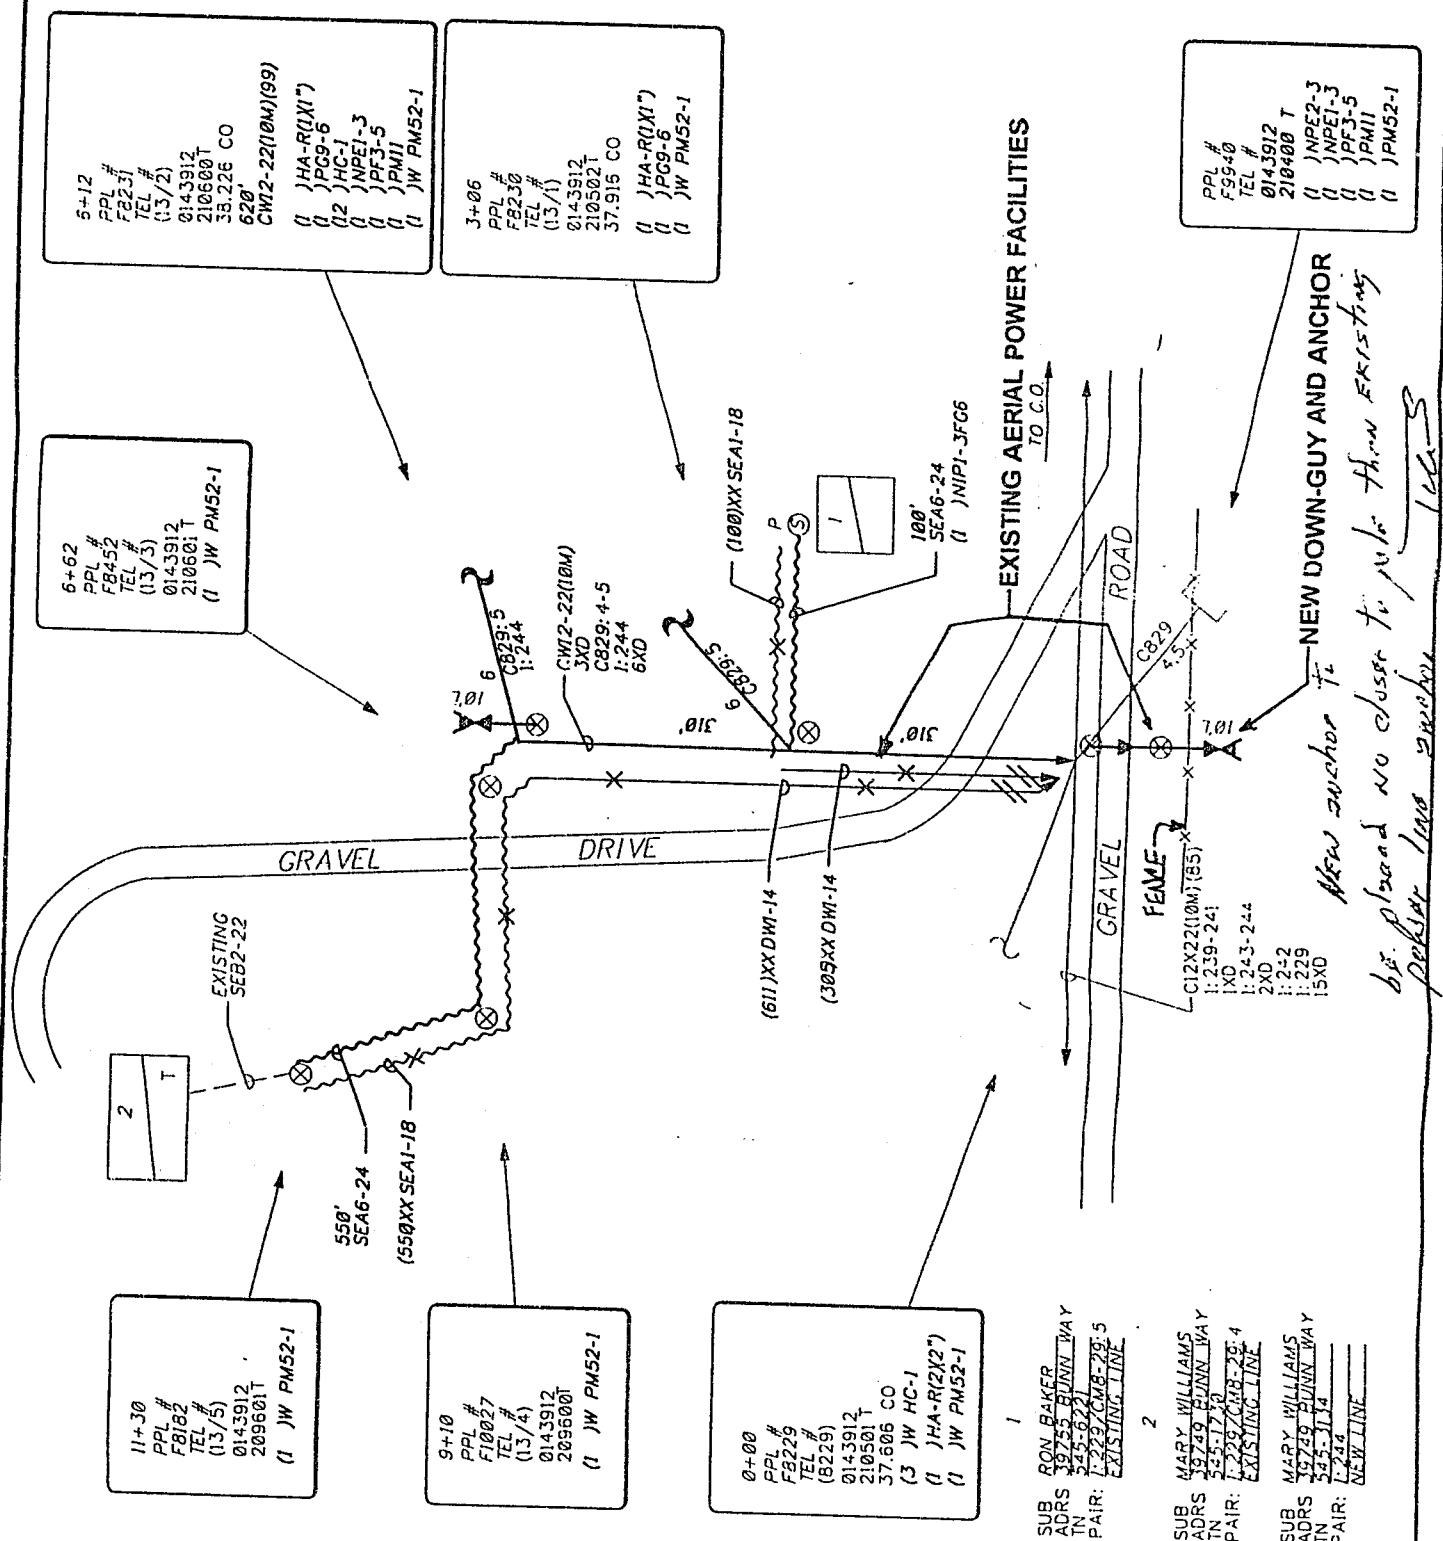

49285

State of Oregon, County of Klamath
Recorded 12/15/99, at 12:53 p.m.
In Vol. M99 Page 49283
Linda Smith,
County Clerk Fee \$ 20.00