## '05 JUN 17 AH10:40

RECORDING REQUESTED BY:

GRANTOR: Wilbur A. Walker GRANTOR: Maria L. Walker

**GRANTEE: PACIFICORP** 

**RETURN TO:** 

PACIFIC POWER 1950 MALLARD LANE KLAMATH FALLS, OR 97601 Vol\_M05\_Page 45508

State of Oregon, County of Klamath Recorded 06/17/05 <u>10.40 a</u> m

Vol M05 Pg <u>45 5 08 - //</u>

Linda Smith, County Clerk

Fee \$ <u>3600</u> # of Pgs 4

## **RIGHT OF WAY EASEMENT**

APR 2 9 2005

## UNDERGROUND RIGHT OF WAY EASEMENT

For value received, Wilbur A. and Maria L. Walker ("Grantor"), hereby grants to PacifiCorp, an Oregon corporation, its successors and assigns, ("Grantee"), a non-exclusive easement for a right of way 10 feet in width and 60 feet in length, more or less, for the construction, reconstruction, operation, maintenance, repair, replacement, enlargement, and removal of an underground electric distribution and communication lines and all necessary or desirable accessories and appurtenances thereto, including without limitation: fibers, cables and other conductors and conduits therefore; and pads, transformers, switches, vaults on, across, or under the surface of the real property of Grantor in Klamath County, State of Oregon, more particularly described as follows and as more particularly described and/or shown on Exhibit(s) A B attached hereto and by this reference made a part hereof:

Said property generally located in the SW 1/4 NW 1/4 of Section 10 Township 39S Range 10E of the Willamette Meridian and more specifically described in Volume M76 Page4417 in the official records of Klamath County.

Assessor's Map No. 3910-010BC-00400-000

OFFICIAL SEAL

MY COMMISSION EXPIRES DEC. 12, 2006

Tax Parcel No. 400

Together with the right of access to the right of way from adjacent lands of Grantor for all activities in connection with the purposes for which this easement has been granted; and together with the present and (without payment therefore) the future right to keep the right of way clear of all brush, trees, timber, structures, buildings and other hazards which might endanger Grantee's facilities or impede Grantee's activities.


At no time shall Grantor place, light any fires, place or store any flammable materials (other than agricultural crops), on or within the boundaries of the right of way. Subject to the foregoing limitations, the surface of the right of way may be used for agricultural crops and other purposes not inconsistent, as determined by Grantee, with the purposes for which this easement has been granted.

The rights and obligations of the parties hereto shall be binding upon and shall benefit their respective heirs, successors and assigns.

$m{\Lambda}$			
DATED this 29 day of Dril 2005.			
Willand Wolfe Maria L. Walker (Grantor)  Wilbur A. Walker (Grantor)  Maria L. Walker (Grantor)  Maria L. Walker (Grantor)			
INDIVIDUAL OR REPRESENTATIVE ACKNOWLEDGEMENT			
State of Organ			
County of Klamath } ss }			
on 04-29-05 before me, Rita F. Collins			
Name, Title or Officer (eg Jane Doe, Notary Public)			
personally appeared Wilbur a. Walker and Marie L. Walker			
Name(s) of Signer(s)			
personally known to me ~ OR ~ proved to me on the basis of satisfactory evidence to be the person(s) whose name(s) is/are subscribed to the within instrument and acknowledged to me that he/she/they executed the same in his/her/their authorized capcity(ies) and that by his/her/their signature(s) on the instrument the person(s), or the entity upon behalf which the person(s) acted, executed this instrument			

WITNESS my hand and official seal.

SIGNATURE OF NOTARY

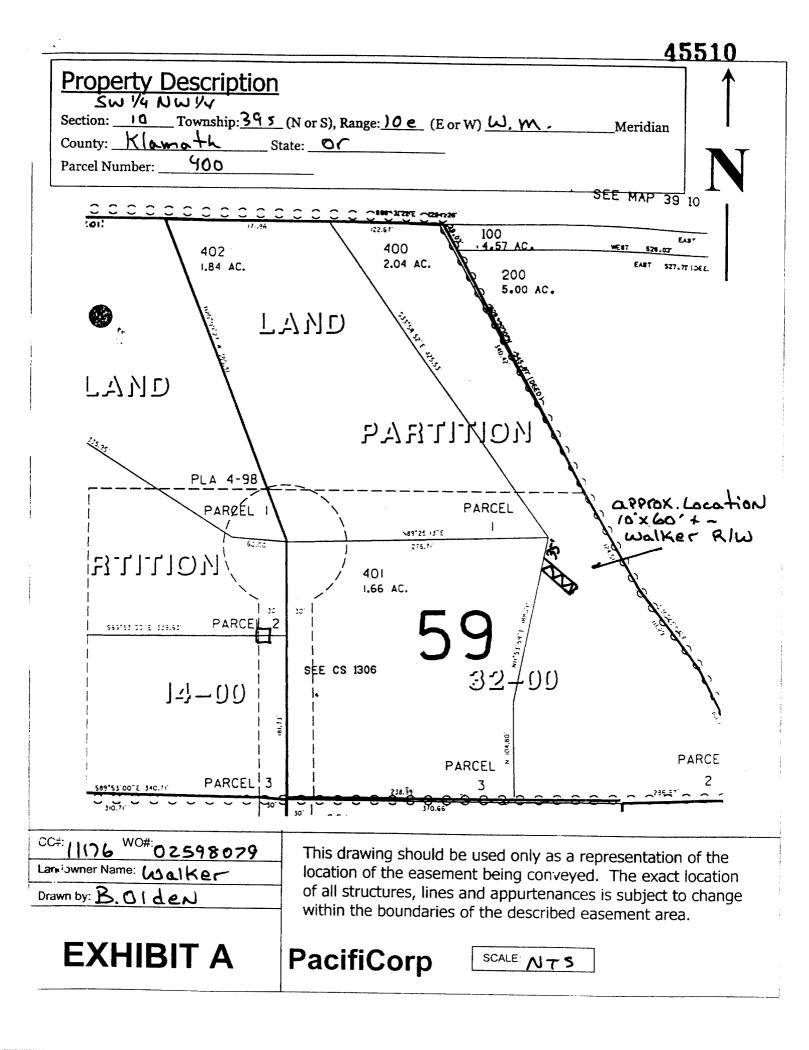

	11907	WARRANT DEED	
***	KNOW ALL MEN BY THESE PRESE		
Proporty Docer	Ingresenter called the granter, for the committees	has inseinative einted, to grantee part by Wilbur A. Walker	•
Property Descr	ptioneria L. Walker, Husband		
	nertaining, situated in the County of Klama	th and Sinte of Deagon, described as follows, in mit.	
<i>i</i> •	That portion of the Swynw, of	Section 10 Mounthly 20 Carries name	
<b>被</b> 全	agagganda an tottianal	an, Klamath County, Orogon, nore particularly	•
ž.	Commencing at the 4 corner cor Range 10 East of the Willeman	mmon to Sections 9 and 10, Township J9 South, to Moridian, Klamath County, Orogon: thence	. •
` :		•	
	iron pin; thence North 139.65		
<b>્રા</b>	feet to a S/8 inch iron pin:		
,	beginning containing 5.00 mere		
<u>.</u>	A racordod sarroy Na.245.		
	Til Have and to Hold the smeet will delive and granted their, successors and anigm larrier.  And said granter breshy coverants to and with said grantes and granter's bairs, successors and anigm larrier.		
•	drantor is inwisity ecised in the simple of the ab-	,	
<b>₫</b>	apparent upon end thid, and	Reverse side	<u> </u>
	fraumr will warrant and love, or defend the and	Beetlines and armen must and accord thereof notices the family distribution	• •
3	The true and actual consideration and	thems claiming under the phase described encountries or	
<b>.</b>		i materiale residente, i mentres en sement en contrata, la 3 - CU , CUU , DU I materialentellem elektron efentespa el procedit la mitalitan elfética en este aparamentament la bescha una Materialentellement la reproduction halt para espojarabesparabesparabes el tendo del de la sicilitación	•
₹	in commenting this deed and where the cont	ext an requires, the singular includes the plutal and all granusatical second apply equally to corporations and to individuals.	•
Ą	IN Wilness Wherent, the Atantoe has asecu	ted this instrument this 2 ?" Hay at March , 1976; by signed and seal affixed by its afficers, duly authorised therein by	
ঝ্	order of its based at directors.	Kondo de	
1	(the controlled for a compound on after appropriate and)	, , ,	
Ž.			1
<del>«</del>	STATE OF DAESON, } County WKlamath }"	STATE OF UKEGON, Countries 344	
<u>*</u>	March 29. 14 76	Personally appeared and	
<u>्र</u>	Personally approved the also a money	onth her himself and out and for the other, tild out that the lateur is the previous and stat the latest is the	, <del></del> -
A AS P. S.	Ronald Lea	potrotary of	
į	nione to the 2028 contractor of the foregoing lines with the transfer of the 2028.	and that the cost attland to the berequing increment is the corporare sent of and purposestion and thus sold instrument was algebra and popular in ter-	7
į	MOPPICIAL TOLLERS - L. DILTER	hall of soft contraction by authority of its board of dire imaginal each of Horn achomologist sold increment to be its voluntary set and dood. Below their	••
<b>S</b>	SCAL) Metery Public for Corpora	(DFFICIAL SEAL) Matery Public for Orogen	
•	Mr consider media. \$7/90	My commission aspeces	
7,		STATE OF OREGON,	• •
•	STARTOR S NAME AND COLORS	County of	
3		I cartily that the within instru-	True .
•	PROPERTY AND ABORDS	dey of 19	
:	FFSVL	orate assessed in book on page nr es	
	-main Br.	Record of Dads of said country.  Witness on hand and seal of	11 m
	brett a change it requested all has absolute that he seed to the following	Coursey allierd.	. 2
	الماسود الماسود	Recording Officer	
•	name, Ampacana, sap	Dr Deputy	
			74
	T		
C#:			
/O#:			
AME:			

**EXHIBIT B** 

DRAWN BY:

**PacifiCorp** 

SCALE:

SHEET

OF