

24877

Vol. m96 Page 28746

When recorded, return to:

Parcel No. OR-KL-4190APN: 391101900-00400

PGT - Land Dept.

P.O. Box 547

Redmond, OR 97756-0125

NOTICE OF LOCATION

PACIFIC GAS TRANSMISSION COMPANY, a California corporation, pursuant to the rights conveyed to it by that certain grant of easement dated April 15, 1996 and recorded in Vol M96 of Deeds at Page 10384 in the Official Records of the County of Klamath, State of Oregon, does hereby further define the location of the strip of lands described in said grant as follows on the attached Exhibit A.

Nothing herein contained shall, or shall be construed to, modify in any way to terminate any of the rights and obligations of the parties under and by virtue of the said grant of easements in the lands therein described or the said strip thereof.

IN WITNESS WHEREOF, the undersigned has executed these presents this 20th day of August, 1996.

PACIFIC GAS TRANSMISSION COMPANY

By: W.G. Thomas
W.G. Thomas, Director Land

TLR

STATE OF OREGON }
County of Multnomah } ss.

On this 20th day of August, 1996, before me appeared W. G. Thomas, to me personally known, who being duly sworn, did say that he, the said W. G. Thomas is the Land Director of Pacific Gas Transmission Company, the within named Corporation, and that the said instrument was signed in behalf of said Corporation by authority of its Board of Directors, and W. G. Thomas acknowledges said instrument to be the free act and deed of said Corporation.

IN WITNESS WHEREOF, I have hereunto set my hand and affixed my official seal the day and year in this Certificate first above written.



Dino Angelosante
DINO ANGELOSANTE
NOTARY PUBLIC FOR OREGON
My Commission Expires: August 16, 1998


96 SEP 12 AM 1:39

REGISTERED
PROFESSIONAL
LAND SURVEYOR

Joe Arndt

OREGON
JANUARY 17, 1995
JOSEPH A. FEYDER
2692

RENEWAL DATE 12-31-97

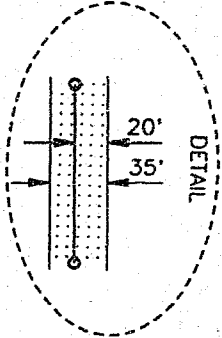

KLAMATH COUNTY, OREGON
SEC. 19, T-39-S, R-11-E, W.M.

NARRATIVE

1. THE PURPOSE OF THIS MAP AND NOTATIONS IS TO DEPICT AND DESCRIBE AN EASEMENT, BEING A PORTION OF THE NORTHEAST QUARTER OF SECTION 19, T.39 S., R.11 E., W.M., KLAMATH COUNTY, OREGON.

2. BASIS OF BEARINGS IS OREGON STATE PLANE COORDINATE SYSTEM, SOUTH ZONE. ALL DISTANCES ARE GRID. DIVIDE DISTANCES SHOWN BY 0.99985 TO OBTAIN GROUND DISTANCES.


DESCRIPTION OF EASEMENT

A 0.47 ACRE PARCEL OF LAND FOR THE AS-BUILT LOCATION OF A NATURAL GAS PIPELINE, BEING A STRIP OF LAND 35.0 FEET WIDE LYING 15.0 FEET TO THE LEFT OF AND 20.0 FEET TO THE RIGHT OF THE FOLLOWING DESCRIBED LINE:

BEING A PORTION OF THAT CERTAIN PARCEL OF LAND DESCRIBED BY DOCUMENT RECORDED IN VOLUME M89 OF DEEDS AT PAGE 6631, RECORDED IN THE OFFICIAL RECORDS OF SAID KLAMATH COUNTY.

BEGINNING AT A POINT ON THE SOUTH LINE OF THAT PARCEL DESCRIBED IN SAID DEED, FROM WHENCE THE NORTHEAST CORNER OF SAID SECTION 19 BEARS N. 16°55'21"E., A DISTANCE OF 1457.64 FEET, THENCE FROM SAID POINT OF BEGINNING, LEAVING SAID SOUTH LINE, N. 60°26'30"W., 386.75 FEET, THENCE N. 63°52'27"W., 168.03 FEET, THENCE N. 60°17'19"W., 27.61 FEET TO A POINT ON THE NORTH LINE OF SAID PARCEL, THE POINT OF TERMINATION OF THIS DESCRIPTION, BEING THE NORTH LINE OF PARCEL NO. 1 PER KLAMATH COUNTY SURVEY NO. 1570, FROM WHENCE THE NORTHWEST CORNER OF SAID PARCEL NO. 1 BEARS N. 84°59'06"W., A DISTANCE OF 132.52 FEET, SAID POINT MARKED BY A 5/8" IRON PIN PER SAID KLAMATH COUNTY SURVEY NO. 1570.

THE SIDELINES OF SAID STRIP SHALL BE SHORTENED OR EXTENDED SO AS TO INTERSECT WITH THE BOUNDARIES OF SAID LANDS.

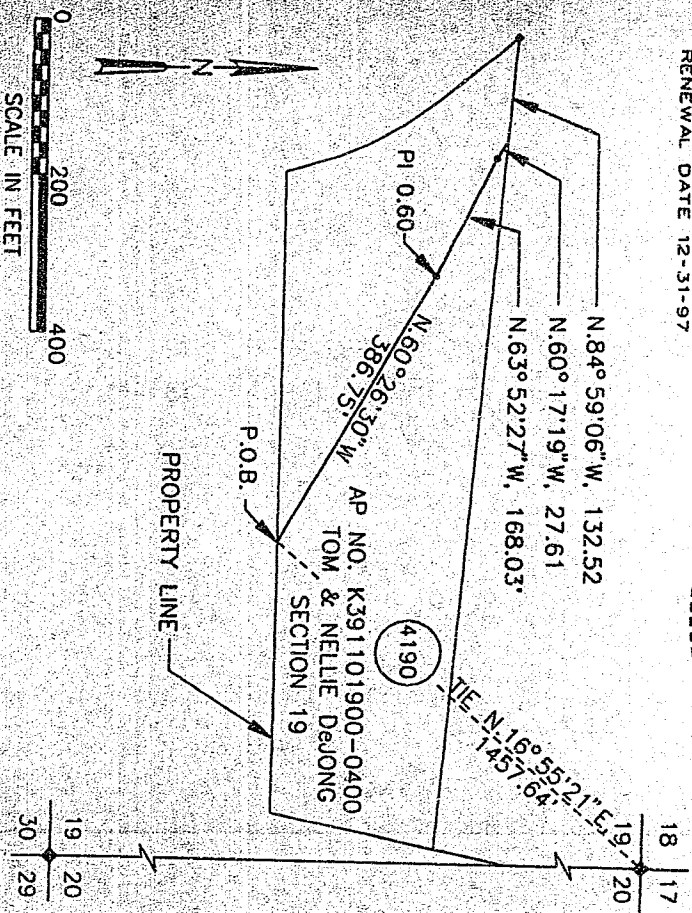

TRACT NO. 0-KL-4190

04/19 AS-BUILT		DESCRIPTION		W.O.	DR.	RDE	HW	CH.	APPROVALS	DATE APR 96	
W.O. 999444		RIGHT-OF-WAY PLAT SHEET		SUPV		DSGN JF		SEC. 19, T-39-S, R-11-E, W.M.		BILL OF MATERIAL	
DWN RDE		PIPELINE EASEMENT		CHKD HW		PACIFIC GAS TRANSMISSION COMPANY		SUPERSEDES		SHEET 1 OF 1	
DATE APR 96		DRAWING NUMBER 1700-F-RW-6		CHG		0		SCALE 1" = 200'		DRAWING NUMBER 1700-F-RW-6	

EXHIBIT A



 RECEIVED

Filed for record at request of PGT-Land Dept. the 12th day
of September A.D. 1996 at 11:39 o'clock AM. and duly recorded in Vol. M96,
of Deeds on Page 28746.

Bernetha G Letsch, County Clerk
By Christy Russell

642515 [1995] 53




FROM PARCELS 1, 2, 84

[illegible]

