2019-007355 Klamath County, Oregon

Returned at Counter

Return to: Pacific Power 1950 Mallard Ln.

Klamath Falls, OR 97601

00242958201900073550030034

06/28/2019 03:31:09 PM

Fee: \$92.00

CC#: 11176 WO#: 6592280

UNDERGROUND RIGHT OF WAY EASEMENT

For value received, Josh R. Fuhrer ("Grantor"), hereby grants to PacifiCorp, an Oregon corporation, its successors and assigns ("Grantee"), a perpetual easement for a right of way 10 feet in width and 500 feet in length, more or less, for the construction, reconstruction, operation, maintenance, repair, replacement, enlargement, and removal of Grantee's underground electric distribution and communication lines and all necessary or desirable accessories and appurtenances thereto, including without limitation: wires, fibers, cables and other conductors and conduits therefor; and pads, transformers, switches, cabinets, vaults on, across, or under the surface of the real property of Grantor in Klamath County, State of Oregon, as more particularly described as follows and/or shown on Exhibit(s) A attached hereto and by this reference made a part hereof:

A portion of:

Parcel 2 of Land Partition 36-03 being a replat of Parcel 2 and a portion of Parcel 1 of Major Land Partition 81-05 situated in the SW 1/4 of Section 12, Township 39 South, Range 8 East of the Willamette Meridian, Klamath County, Oregon

Assessor's Map No.: 3908-012C0-00102-000 Parcel No.: 892796

Together with the right of ingress and egress for Grantee, its contractors, or agents, to the right of way from adjacent lands of Grantor for all activities in connection with the purposes for which this easement has been granted; and together with the present and (without payment therefor) the future right to keep the right of way clear of all brush, trees, timber, structures, buildings and other hazards which might endanger Grantee's facilities or impede Grantee's activities.

At no time shall Grantor conduct or permit any ground penetrating activity or excavation in the right of way without the express written consent of the Grantee. Subject to the foregoing limitations, the right of way may be used for other purposes not inconsistent, as determined by the Grantee, with the purposes for which this easement has been granted.

JURY WAIVER. TO THE FULLEST EXTENT PERMITTED BY LAW, EACH OF THE PARTIES HERETO WAIVES ANY RIGHT IT MAY HAVE TO A TRIAL BY JURY IN RESPECT OF LITIGATION DIRECTLY OR INDIRECTLY ARISING OUT OF, UNDER OR IN CONNECTION WITH THIS EASEMENT. EACH PARTY FURTHER WAIVES ANY RIGHT TO CONSOLIDATE, OR TO REQUEST THE CONSOLIDATION OF, ANY ACTION IN WHICH A JURY TRIAL HAS BEEN WAIVED WITH ANY OTHER ACTION IN WHICH

A JURY TRIAL CANNOT BE OR HAS NOT BEEN WAIVED. THIS PARAGRAPH WILL SURVIVE THE EXPIRATION OR TERMINATION OF THIS AGREEMENT.

Grantor represents and warrants that it possesses all right, title and interest in and to the right of way area, free and clear of any lien, security interest, encumbrance, claim, license or other restriction that would interfere with Grantee's use of the right of way area for the purposes contemplated hereunder.

The rights and obligations of the parties hereto shall be binding upon and shall benefit their respective heirs, successors and assigns and shall run with the land.

Dated this3	_day of <u>June</u>
In 11/2	
Josh R. Fuhrer GRANTOR	
INDIVIDUAL ACKNOWLEDGEMENT	
State of Oregon	-)
County of Klamath	ss.
This instrument was acknowledged before no by Joshua R. Fuhrer	ne on this 3 day of 3 ,
	of individual(s) signing document
OFFICIAL STAMP	Valerie K Madanona
VALERIE KAYE MANTANONA NOTARY PUBLIC - OREGON COMMISSION NO. 977122 MY COMMISSION EXPIRES JULY 31, 2022	Notary Public My commission expires: July 31, 2022
	My commission expires:


PROPERTY DESCRIPTION

In the SW 1/4 of Section 12, Township 39S, Range 08E of the W.M. Meridian, Klamath County, State of Oregon.

Map / Tax Lot or Assessor's Parcel No.: 3908-012C0-00102-000



Easement approximate as shown, 10' wide X 30' long, 5' on either side of the overhead distribution line, including pole and anchor, as constructed in the field. OVERHEAD EASEMENT

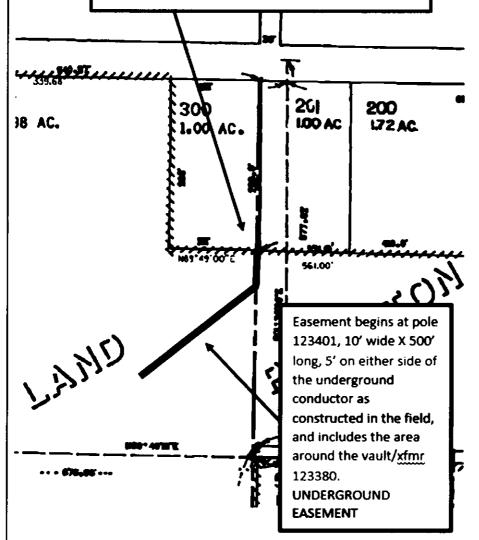

CC#:11176 WO#: 6592280 ROW#:

Landowner: Josh Fuhrer

Drawn by: Shelangouski

EXHIBIT A

This drawing should be used only as a representation of the location of the easement area. The exact location of all structures, lines and appurtenances is subject to change within the boundaries of the described easement area.

