2019-007357 Klamath County, Oregon

00242960201900073570030036

06/28/2019 03:33:56 PM

Fee: \$92.00

Return to: Pacific Power 1950 Mallard Ln. Klamath Falls, OR 97601

CC#: 11176 WO#: 6592280

## **RIGHT OF WAY EASEMENT**

For value received, Josh R. Fuhrer ("Grantor"), hereby grants to PacifiCorp, an Oregon corporation, its successors and assigns, ("Grantee"), a perpetual easement for a right of way 10' feet in width and 30 feet in length, more or less, for the construction, reconstruction, operation, maintenance, repair, replacement, enlargement, and removal of Grantee's electric power transmission, distribution and communication lines and all necessary or desirable accessories and appurtenances thereto, including without limitation: supporting towers, poles, props, guys and anchors, including guys and anchors outside of the right of way; wires, fibers, cables and other conductors and conduits therefor; and pads, transformers, switches, vaults and cabinets, along the general course now located by Grantee on, over, across or under the surface of the real property of Grantor in Klamath County, State of Oregon, more particularly described as follows and/or shown on Exhibit(s) A attached hereto and by this reference made a part hereof:

A portion of:

Parcel 2 of Land Partition 36-03 being a replat of Parcel 2 and a portion of Parcel 1 of Major Land Partition 81-05 situated in the SW 1/4 of Section 12, Township 39 South, Range 8 East of the Willamette Meridian, Klamath County, Oregon

Assessor's Map No. 3908-012C0-00102-000

Parcel No. 892796

Together with the right of ingress and egress, for Grantee, its contractors, or agents, to the right of way from adjacent lands of Grantor for all activities in connection with the purposes for which this easement has been granted; and together with the present and (without payment therefor) the future right to keep the right of way and adjacent lands clear of all brush, trees, timber, structures, buildings and other hazards which might endanger Grantee's facilities or impede Grantee's activities.

At no time shall Grantor place, use or permit any equipment, material or vegetation of any kind that exceeds twelve (12) feet in height, light any fires, place or store any flammable materials, on or within the boundaries of the right of way. Subject to the foregoing limitations, the surface of the right of way may be used for other purposes not inconsistent, as defined by the Grantee, with the purposes for which this easement has been granted.

JURY WAIVER. TO THE FULLEST EXTENT PERMITTED BY LAW, EACH OF THE PARTIES HERETO WAIVES ANY RIGHT IT MAY HAVE TO A TRIAL BY JURY IN RESPECT OF LITIGATION DIRECTLY OR INDIRECTLY ARISING OUT OF, UNDER OR

IN CONNECTION WITH THIS EASEMENT. EACH PARTY FURTHER WAIVES ANY RIGHT TO CONSOLIDATE, OR TO REQUEST THE CONSOLIDATION OF, ANY ACTION IN WHICH A JURY TRIAL HAS BEEN WAIVED WITH ANY OTHER ACTION IN WHICH A JURY TRIAL CANNOT BE OR HAS NOT BEEN WAIVED. THIS PARAGRAPH WILL SURVIVE THE EXPIRATION OR TERMINATION OF THIS AGREEMENT.

Grantor represents and warrants that it possesses all right, title and interest in and to the right of way area, free and clear of any lien, security interest, encumbrance, claim, license or other restriction that would interfere with Grantee's use of the right of way area for the purposes contemplated hereunder.

The rights and obligations of the parties hereto shall be binding upon and shall benefit their respective heirs, successors and assigns and shall run with the land.

Dated this	_day of
Josh R. Fuhrer GRANTOR	
INDIVIDUAL ACKNOWLEDGEMENT	
State of Oregon  County of Klamath	$\left.\begin{array}{c} - \\ - \end{array}\right\}$ ss.
This instrument was acknowledged before me on this 3 day of July, 2019, by	
OFFICIAL STAMP  VALERIE KAYE MANTANONA  NOTARY PUBLIC - OREGON  COMMISSION NO. 977122  MY COMMISSION EXPIRES JULY 31, 2022	Valerie K. Martanona
	Notary Public  My commission expires: July 31, 2022
	Notary Public
	My commission expires:


## **PROPERTY DESCRIPTION**

In the SW 1/4 of Section 12, Township 39S, Range 08E of the W.M. Meridian, Klamath County, State of Oregon.

Map / Tax Lot or Assessor's Parcel No.: 3908-012C0-00102-000



Easement approximate as shown, 10' wide X 30' long, 5' on either side of the overhead distribution line, including pole and anchor, as constructed in the field. OVERHEAD EASEMENT

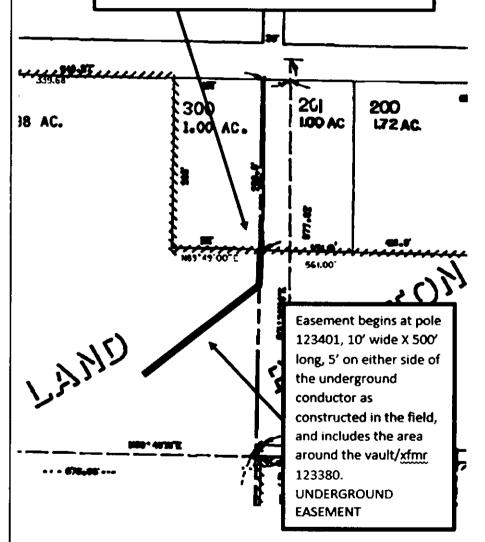

CC#:11176 WO#: 6592280 ROW#:

Landowner: Josh Fuhrer

Drawn by: Shelangouski

**EXHIBIT A** 

This drawing should be used only as a representation of the location of the easement area. The exact location of all structures, lines and appurtenances is subject to change within the boundaries of the described easement area.

